


G 9174
52365

T.27S.,R.17E.,W.M.

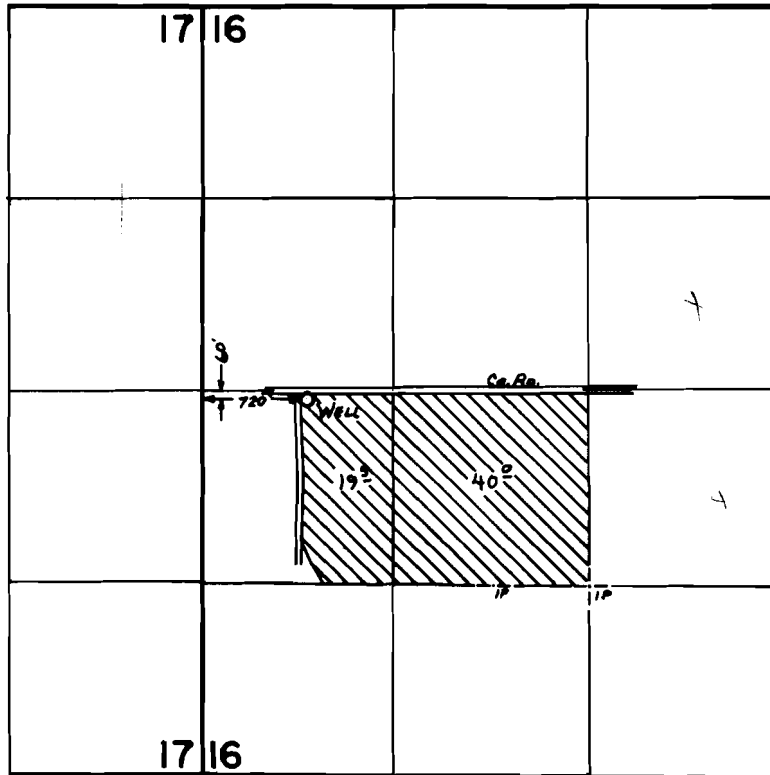

FINAL PROOF SURVEY UNDER

Application No. G-10129. Permit No. G-9174.....
IN NAME OF

.....WALTER J. FOX.....

Surveyed Oct. 14, 1983, by L. M. TOLL.....