


G 9350
G 9351
52366
52367

T.25S.,R.14E.,W.M.

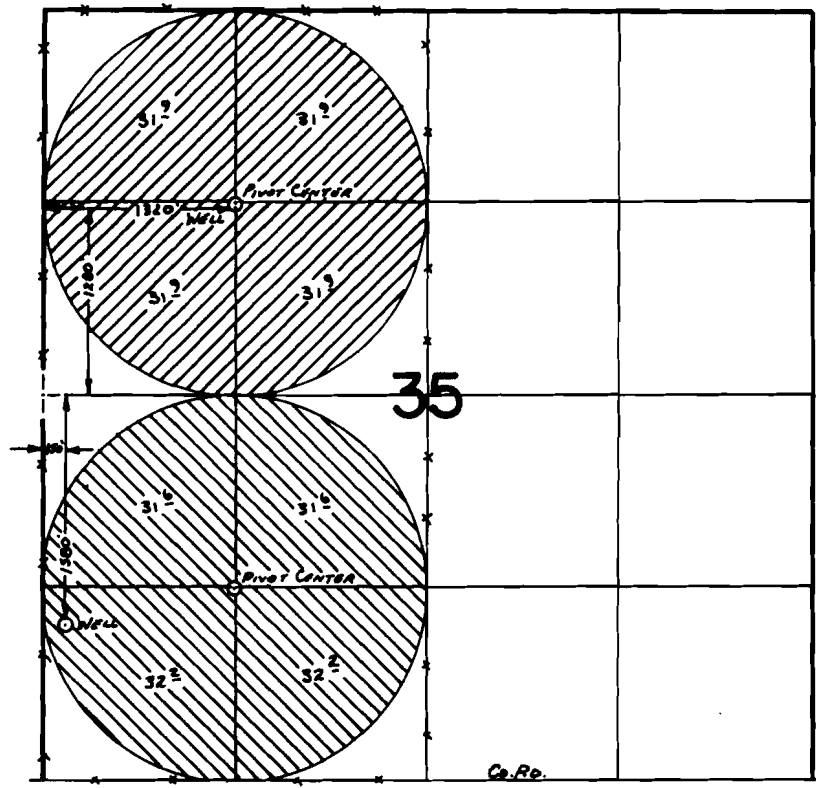

FINAL PROOF SURVEY
UNDER

Application No. G-10293 Permit No. G-9350
G-10294 Permit No. G-9351
IN NAME OF



.....**JOHN & NORMA FLAMING**.....

Surveyed Oct. 19... 1983., by L. M. TOLL.....