


T.16S. R.6W. W.M.

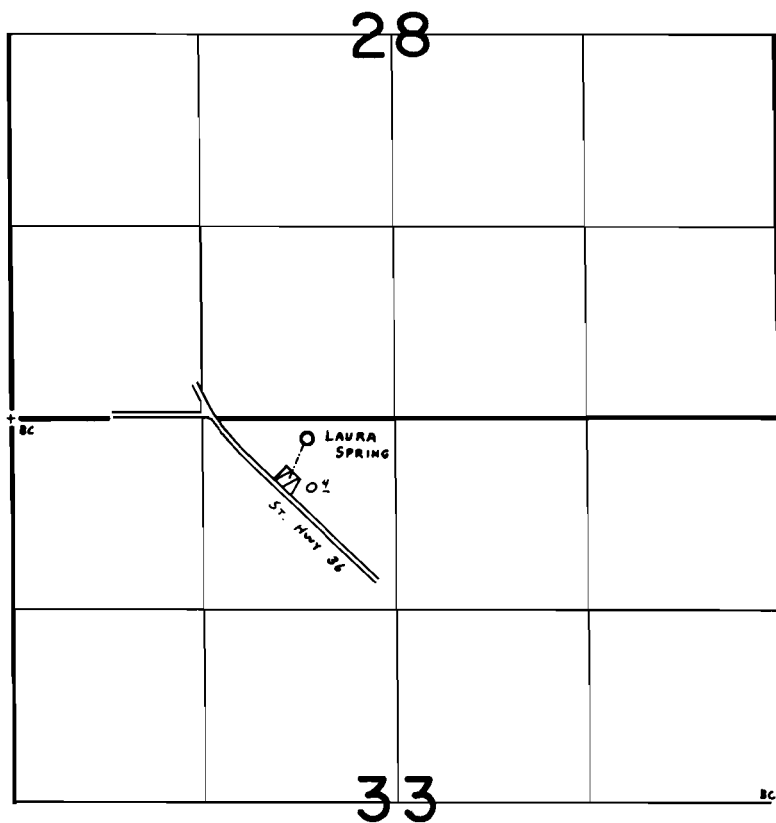

SPRING LOC: 130'S. & 2030'E. fr. N.W. COR. SEC. 33.

FINAL PROOF SURVEY
UNDER

Application No. 49072. Permit No. 37874.....
IN NAME OF

CHARLES REESE.....

Surveyed June 22, 1979, by C. L. HUGHES....