


T20S. R3W. WM.

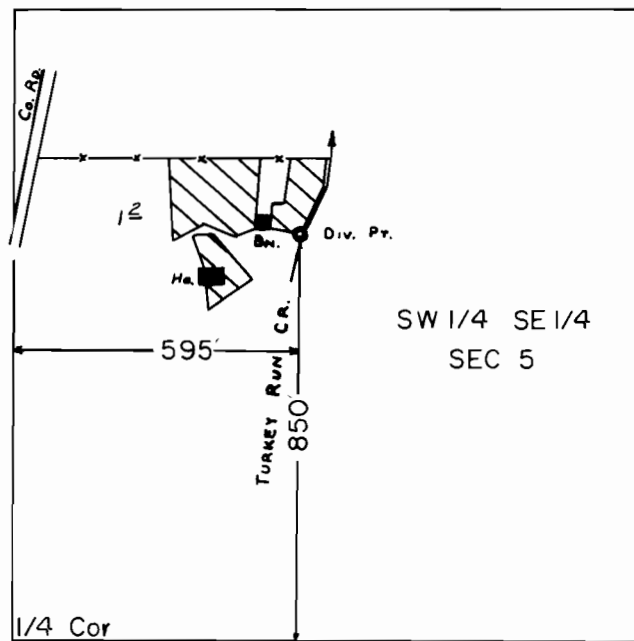

Scale: 1 in. = 400 Ft.

**FINAL PROOF SURVEY
UNDER**

Application No. 52933 Permit No. 39965
IN NAME OF

STEPHEN & LETTY FOTTA

Surveyed Sept. 10, 1979, by C. L. HUGHES