
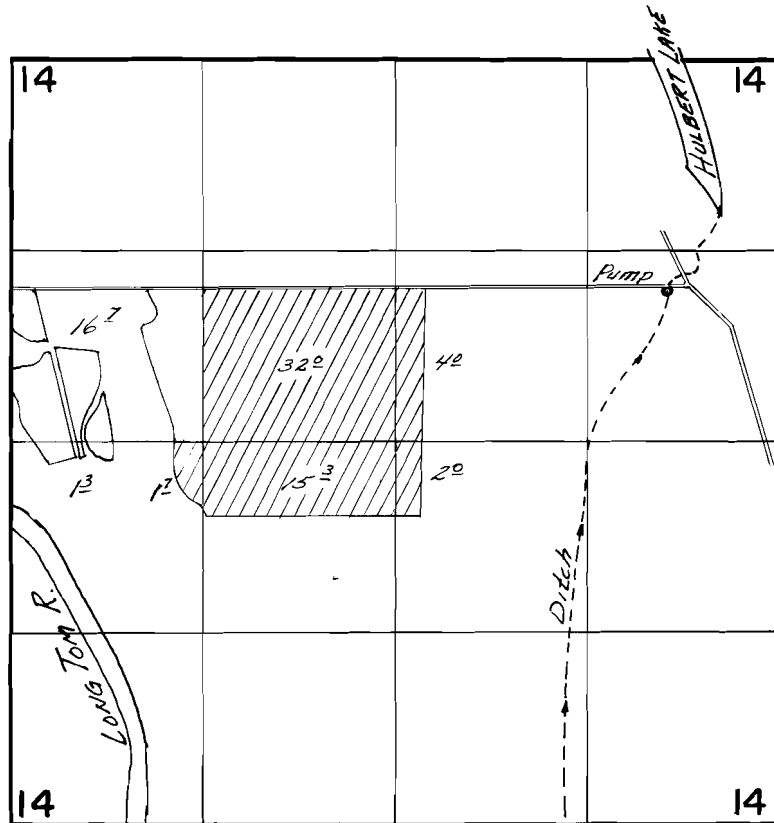


T.15S. R.5W. W.M.

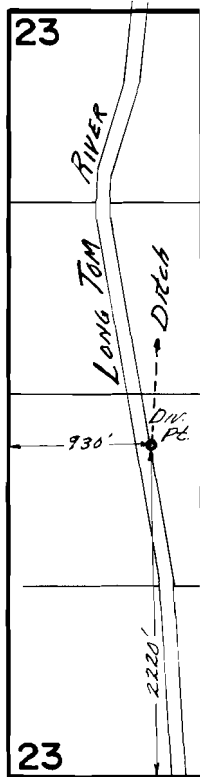

FINAL PROOF SURVEY
UNDER

Application No. 55874. Permit No. 41910.....

IN NAME OF
Bessie D. and
Estate of James T. Neilson.....

Surveyed Oct. 10, 1979., by C. R. RODRIGUEZ.