


T.16S., R.1&2W., W.M.

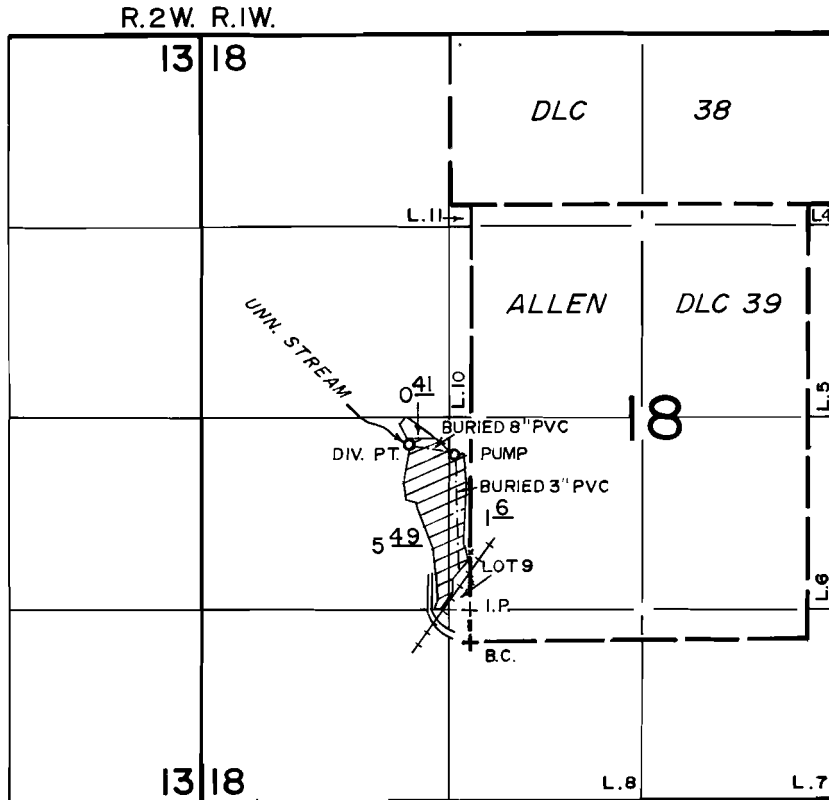

DIV. PT. LOC. 1450' N. & 410' W. FROM SW COR. ALLEN DLC 39.

FINAL PROOF SURVEY UNDER

Application No. 55852.. Permit No. 42507.....
IN NAME OF

.....DEAN DUNSON.....

Surveyed MAY 6..... 1980., by B.W. BISHOP.....