


T. 20S., R. 3W., W.M.

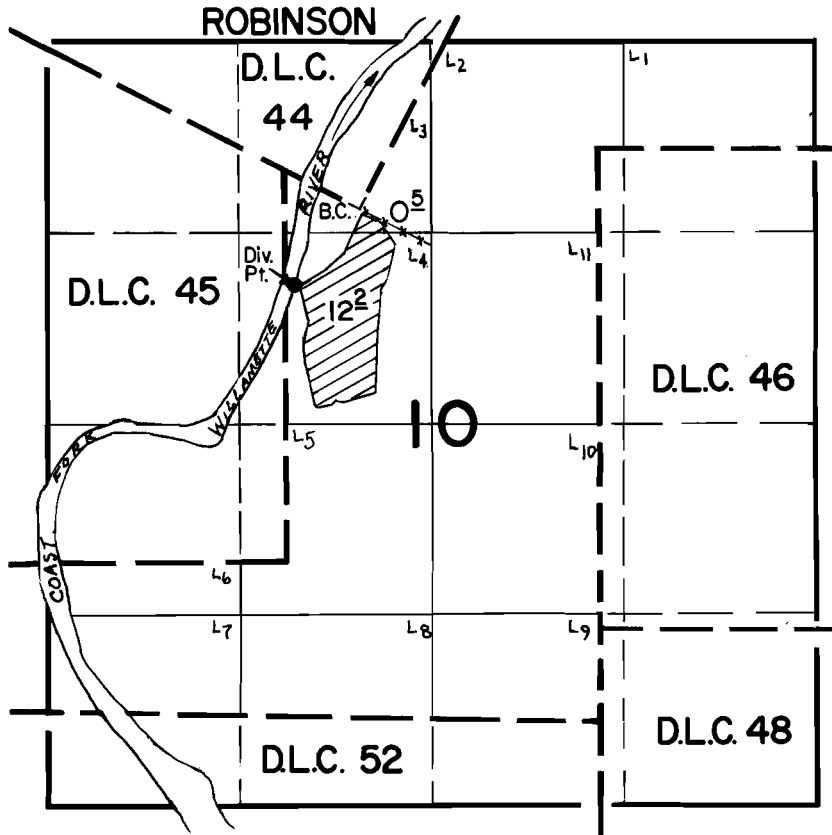

DIVERSION POINT LOCATED 520' S. & 450' W. OF THE S.E. CORNER OF ROBINSON D.L.C. 44

FINAL PROOF SURVEY UNDER

Application No. 55326.. Permit No. 42691.....
IN NAME OF

.....JAMES H. WILLIAMS.....

Surveyed MAY 24, 1979, by *Chris L. Hughes*