


# T16S. R5E. WM.

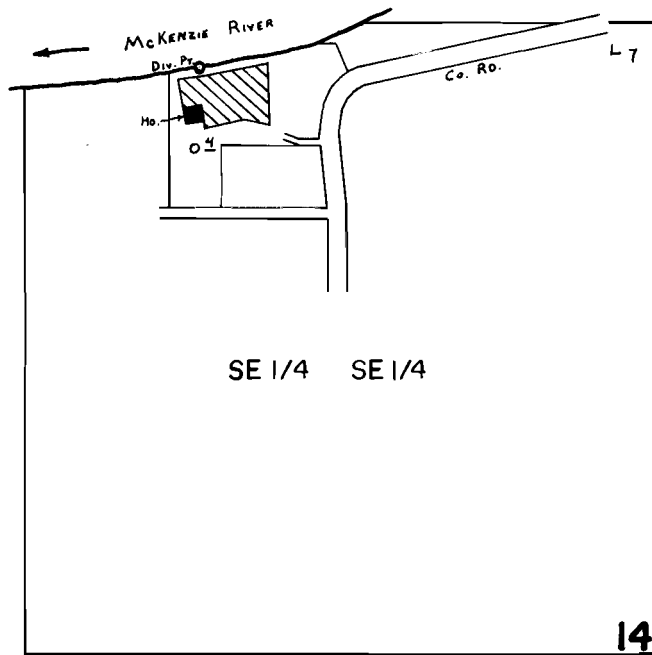

Div. Pt. Loc: 1225' N. & 955' W. fr. SE. Cor. Sec. 14.  
Scale: 1 In. = 400 Ft.

## FINAL PROOF SURVEY UNDER

Application No. 55862 Permit No. 42762  
IN NAME OF

ESTELLE WHITE MACE

Surveyed Sept. 12, 1979, by C.L. HUGHES