


T.17S. R.4W. W.M.

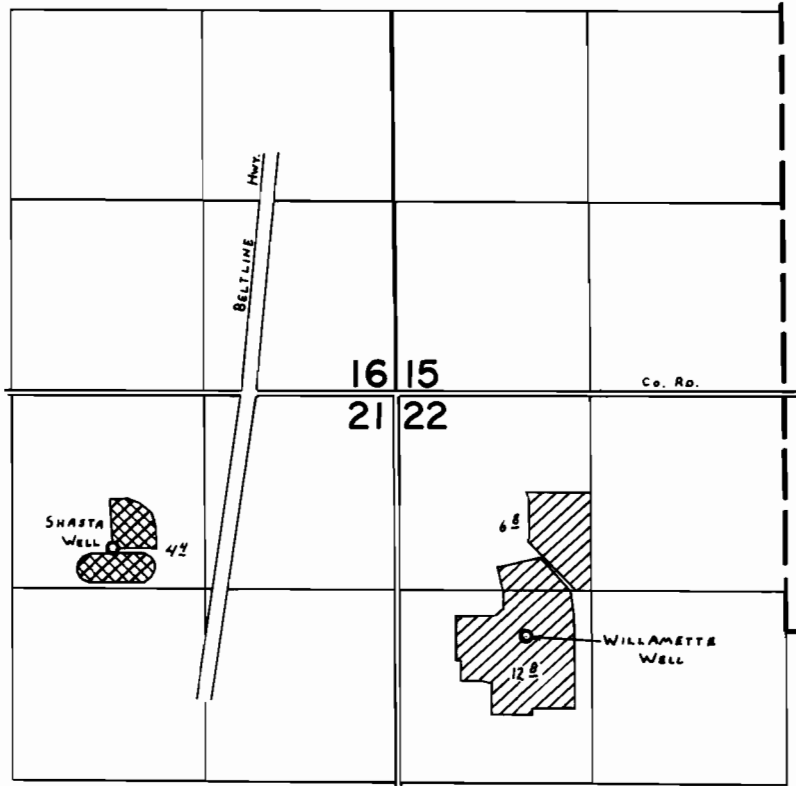

WELLS LOC:

SHASTA- 1070'S. ± 1950'W. fr. N.E. COR. SEC. 21. (App. No. G-6914)

WILLAMETTE- 1670'S. ± 890'E. fr. N.W. COR. SEC. 22. (App. No. G-6915)

FINAL PROOF SURVEY

UNDER

Application No. ~~G-6914~~ **G-6915** Permit No. ~~G-6436~~ **G-6437**
 IN NAME OF



LANE CO. SCHOOL DIST. NO. 52

Surveyed June 19, 1979, by C.L. HUGHES