


T.IOS. R.IOW. W.M.

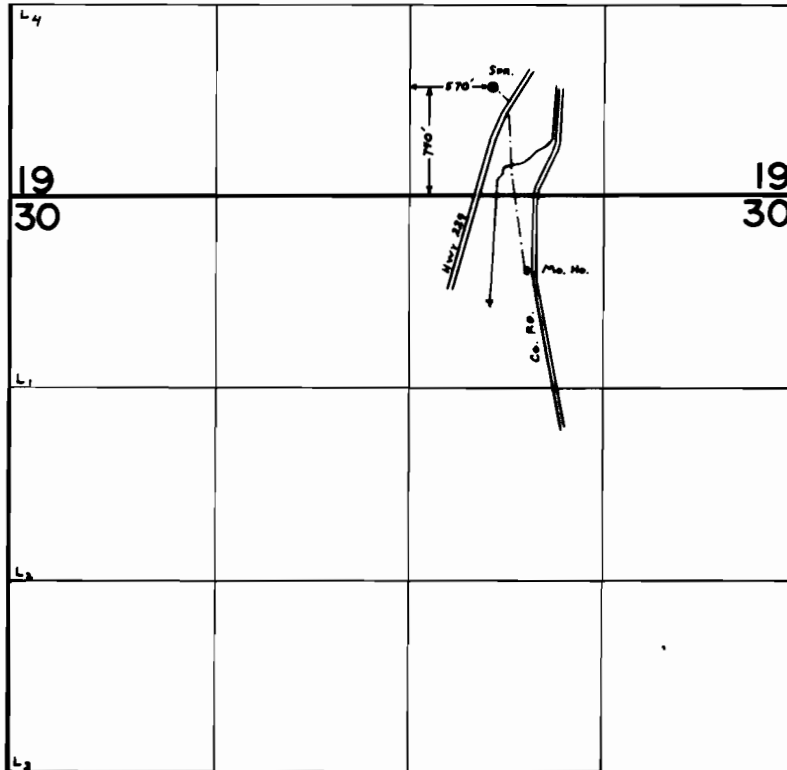

FINAL PROOF SURVEY
UNDER

Application No. 54957.. Permit No. 41247.....
IN NAME OF

.....Charles F. Lamb, Jr.

Surveyed May 22 1980, by C. L. Hughes.....