


T. 10 & 11 S., R. 1 W., W.M.

SHELTON DLC 42

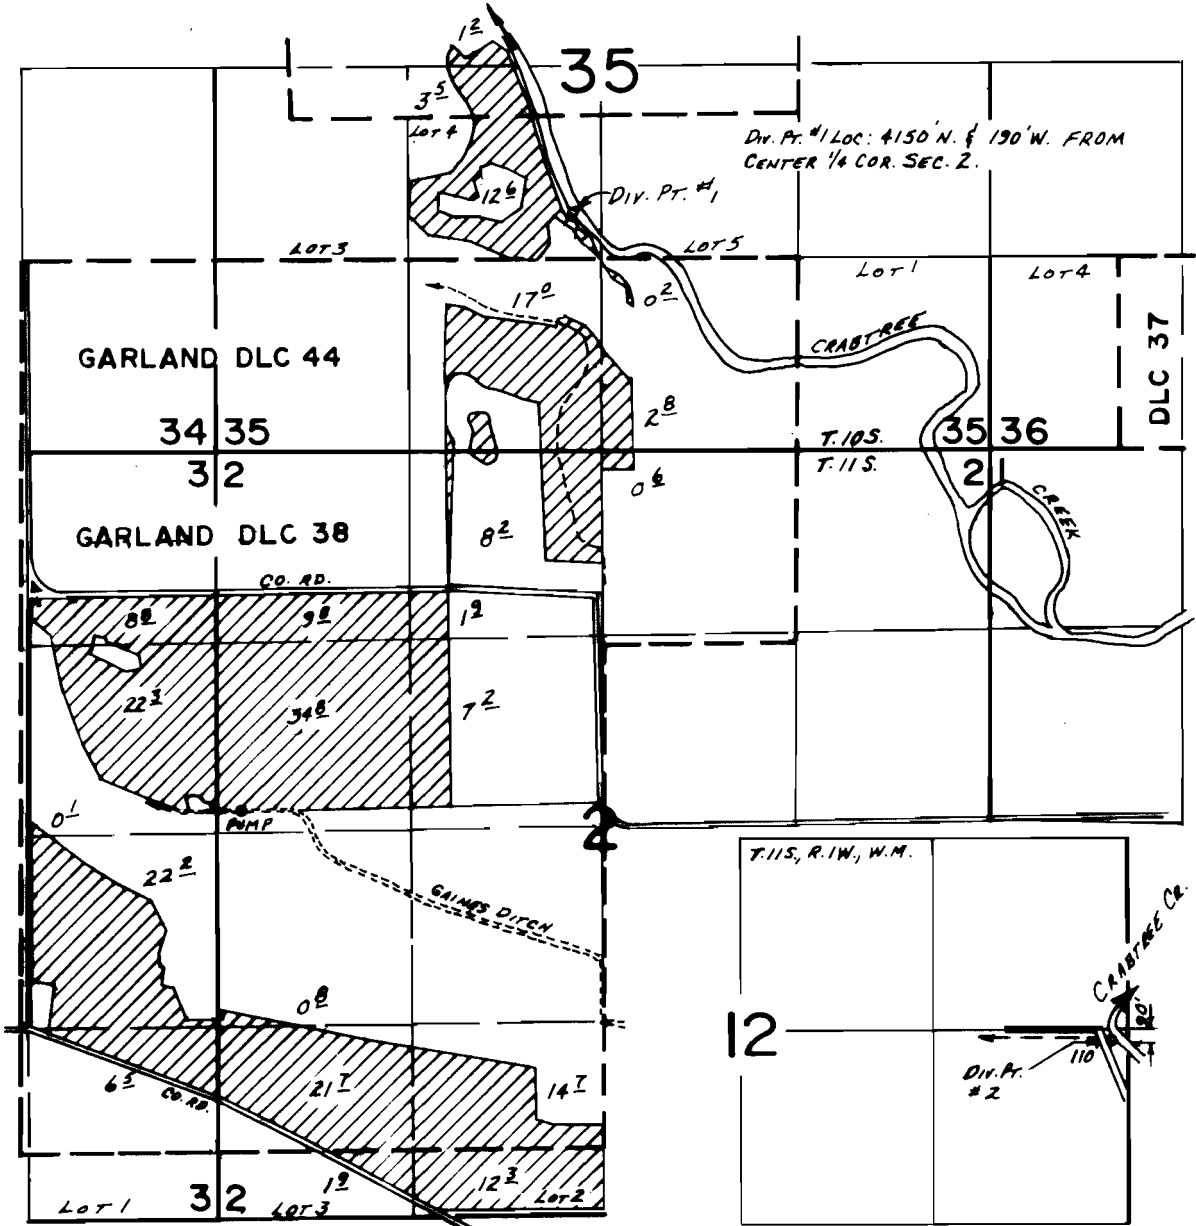

FINAL PROOF SURVEY UNDER

Application No. 54031... Permit No. 40415.....

IN NAME OF

.....STEWART.....

Surveyed JUNE 30, 1982, by L.M. TOLL.....