


T.21S. R.47E. W.M.

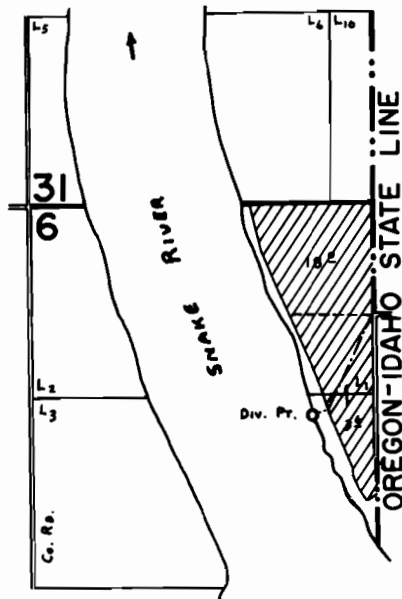

Div. Pt. Loc: 1460'S. & 430'W. fr. N.E. Cor. SEC. 6.

FINAL PROOF SURVEY
UNDER

Application No. 50215 Permit No. 37701
IN NAME OF

J. P. BRUMBACH

Surveyed Sept. 22, 1979, by C. L. HUGHES