


T.22S. R.45E. W.M.

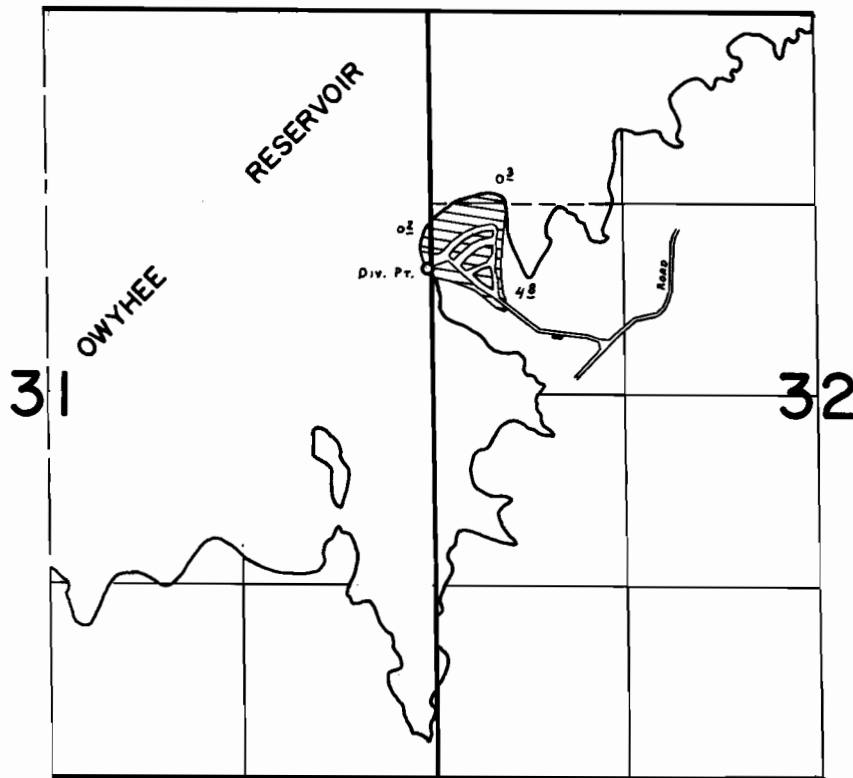

Div. Pr. Loc: 3510' N. & 30' W. fr. S.E. Cor. Sec. 31.

FINAL PROOF SURVEY
UNDER

Application No. 53236 Permit No. 39506
IN NAME OF

OREGON STATE PARKS & RECREATION BRANCH

Surveyed Sept. 23, 1979, by C.L. HUGHES