


T.21S. R.46E. W.M.

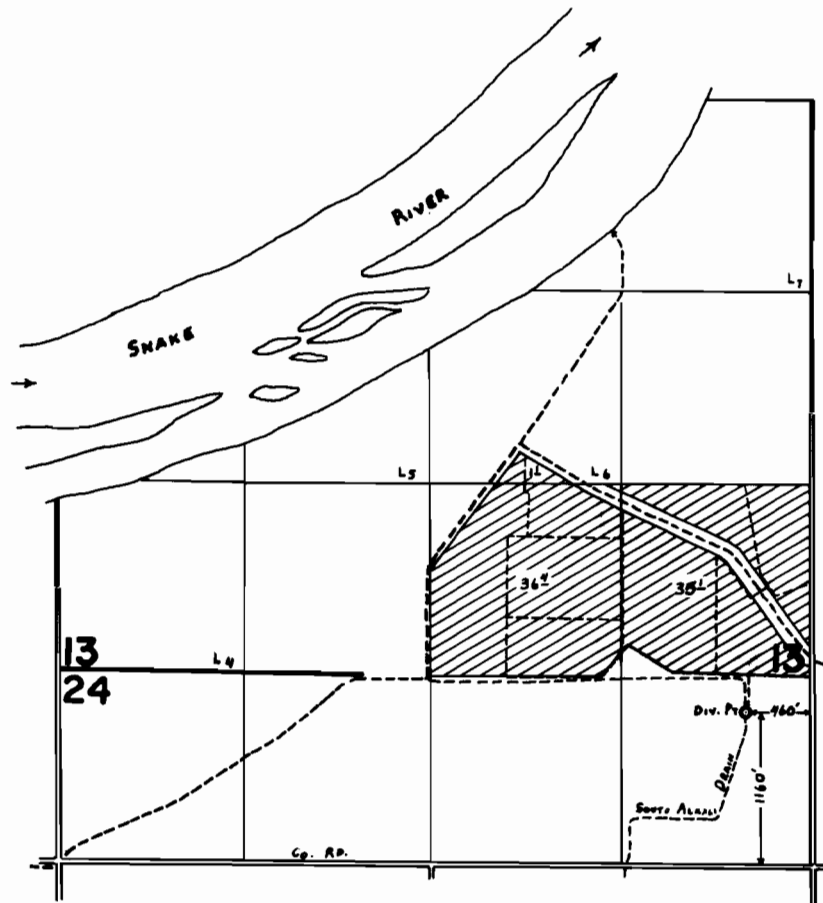

FINAL PROOF SURVEY
UNDER

Application No. 57838... Permit No. 43533...
IN NAME OF

BENNETT-BIG BEND FARMS, INC.

Surveyed Aug. 3, 1979, by C.L. HUGHES...