


T7S RIW WM

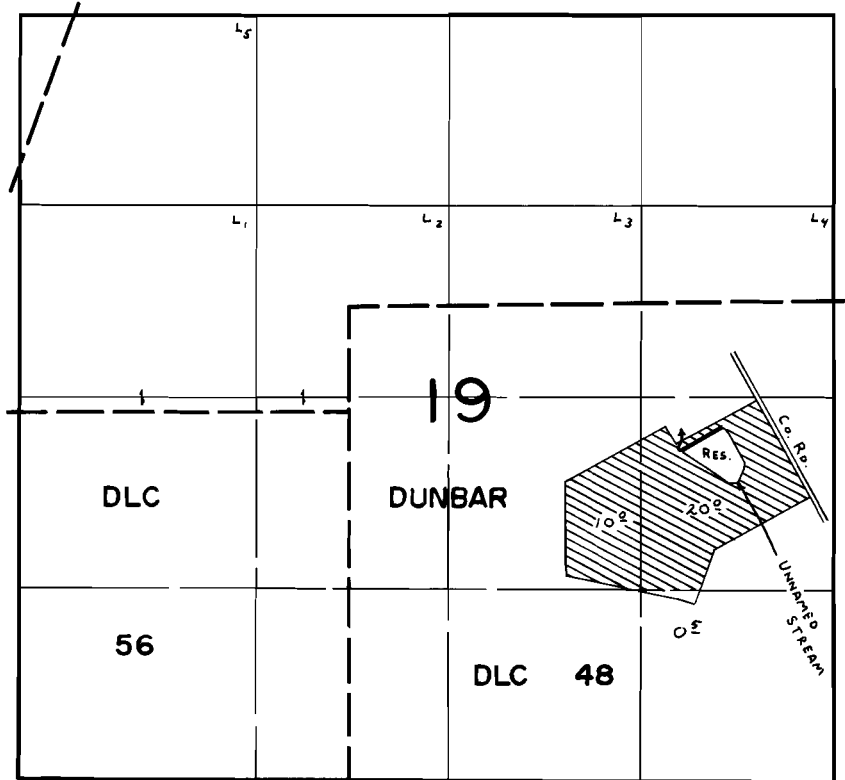

RES. Loc: 930' S. & 2450' E. fr. N.W. Cor. DUNBAR DLC 48.

FINAL PROOF SURVEY UNDER

R-50897 R-6001
 Application No. 50898 Permit No. 36961
 IN NAME OF

KENNETH L. OGREN

Surveyed JUNE 25 1980, by G. L. HUGHES