


T. 4S., R. 1W., W.M.

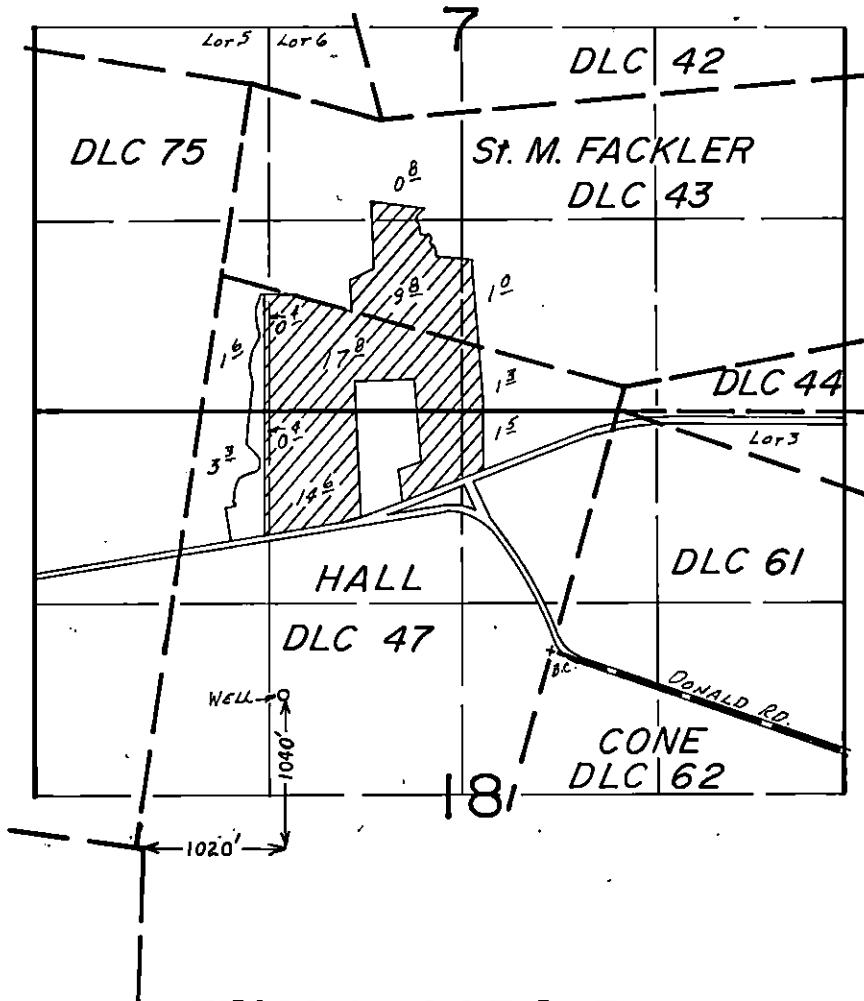

FINAL PROOF SURVEY
UNDER

Application No. G-7860. Permit No. G-8165.....
IN NAME OF

.....FRANCIS X. RYAN.....

Surveyed OCT. 4..... 1983., by L.M. TOLL.....