


G-7878

52397

T. 4N, R. 25E., W. M.

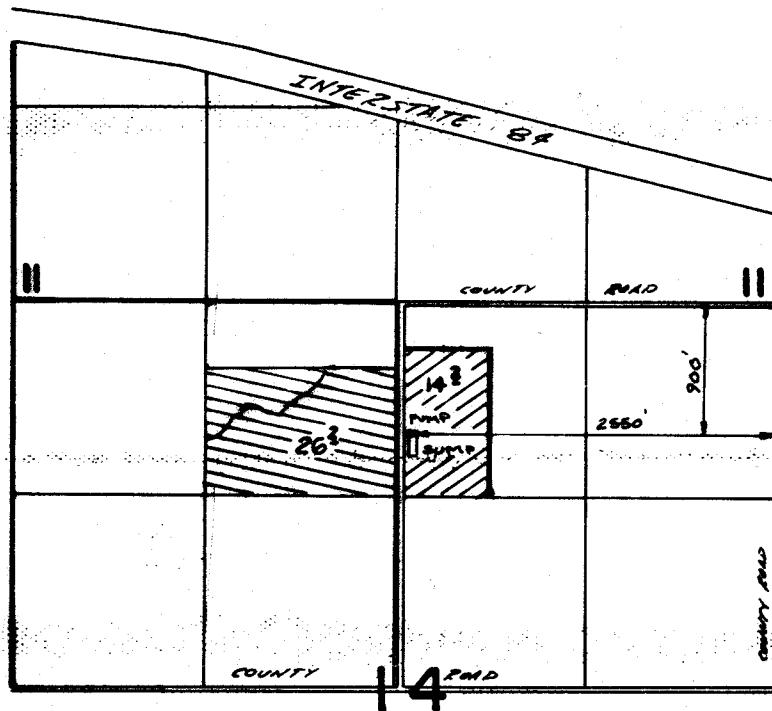

FINAL PROOF SURVEY
UNDER

Application No. G-8552.. Permit No. G-7878.
IN NAME OF

CLARENCE C. & VIRGINIA V. FREDERICKSON

Surveyed 3-16..... 1982, by *Harmon Am Church*

T16 N 1/4 COR
272-18C
PFS-1982-PA