


# T6S. R7W. WM.

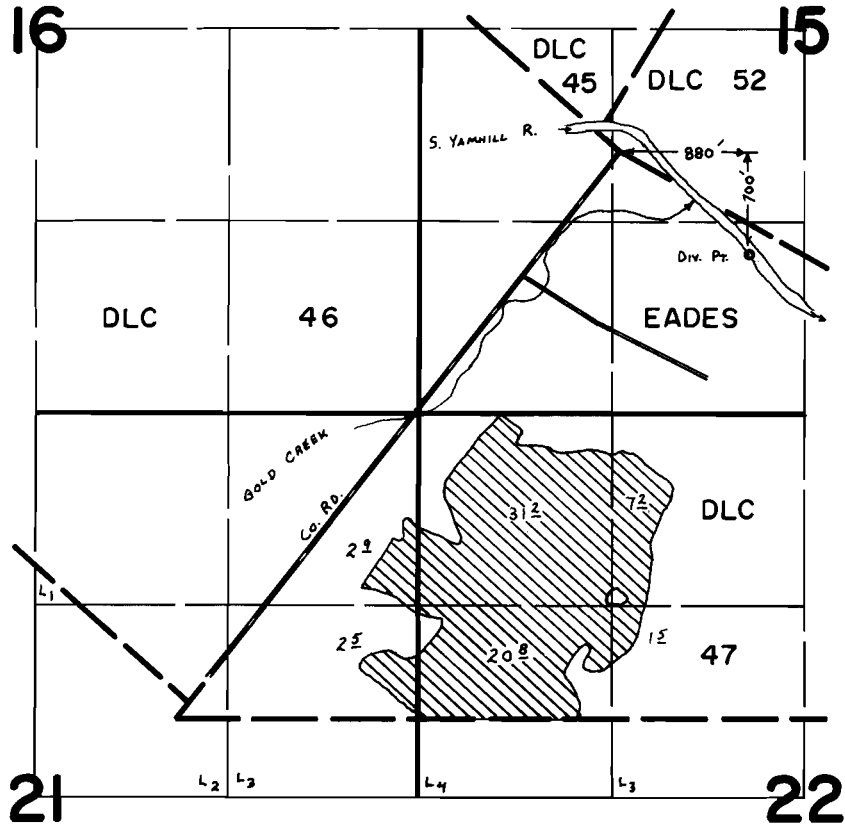

## FINAL PROOF SURVEY UNDER

Application No. 50447. Permit No. 38102....  
IN NAME OF

**KENNETH B. BODE**

Surveyed June 6, 1979, by C. L. HUGHES....