T6S. R3W. WM.

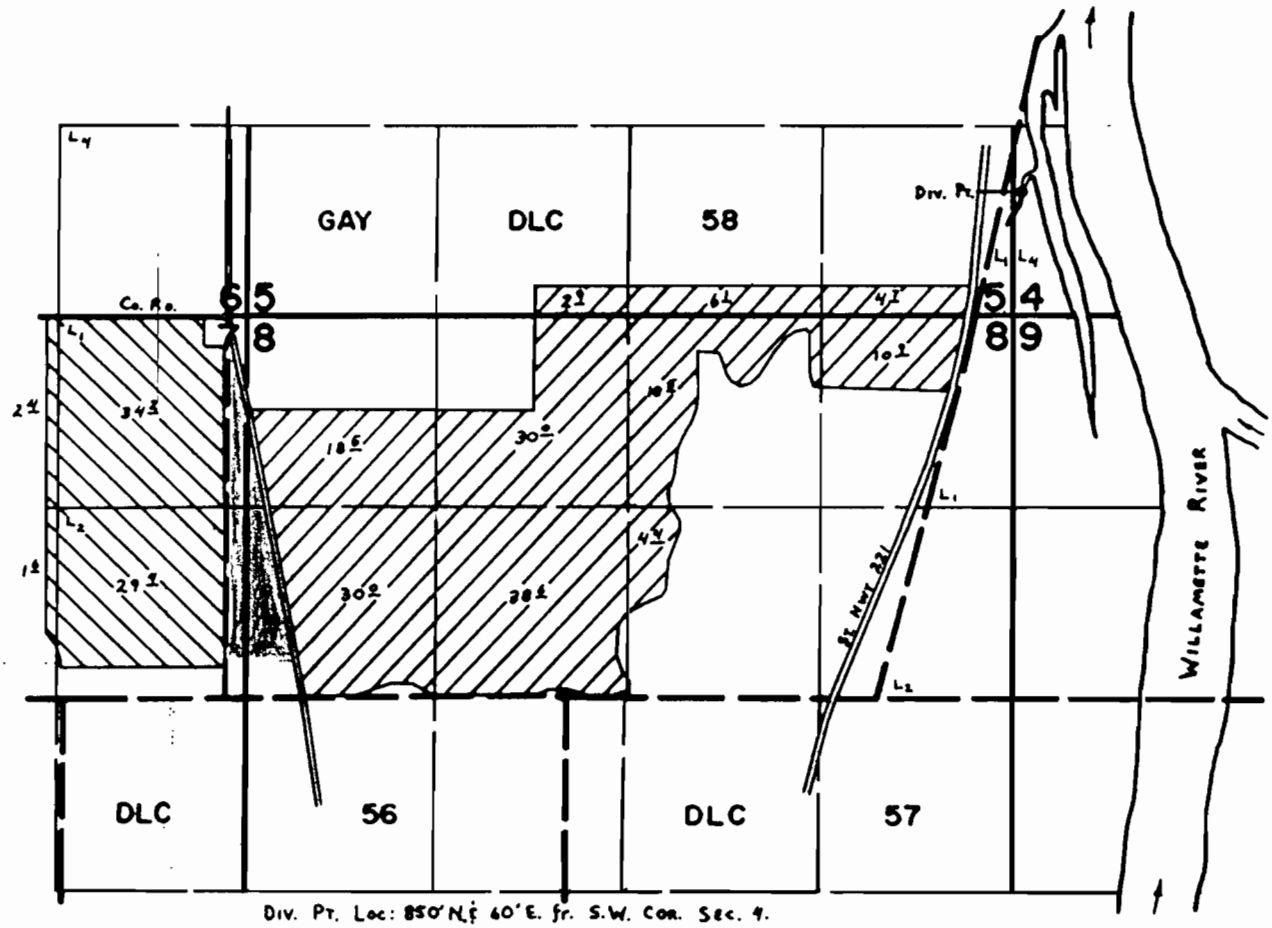

Div. Pt. Loc: 850' N.L. 40' E. fr. S.W. Cor. Sec. 4.

- Primary Irr - App. 47069; Supplemental Irr - App. 55916.
- Primary Irr - App. 47069

FINAL PROOF SURVEY
UNDER

Application No. 47069 55916 Permit No. 35203 42189

IN NAME OF

ANTON P. PIETROK

Surveyed May 15 19 79, by C. L. HUGHES

DFP-244-192
DFP-244-339
PT3-1979-J