


T.9S. R.4W. W.M.

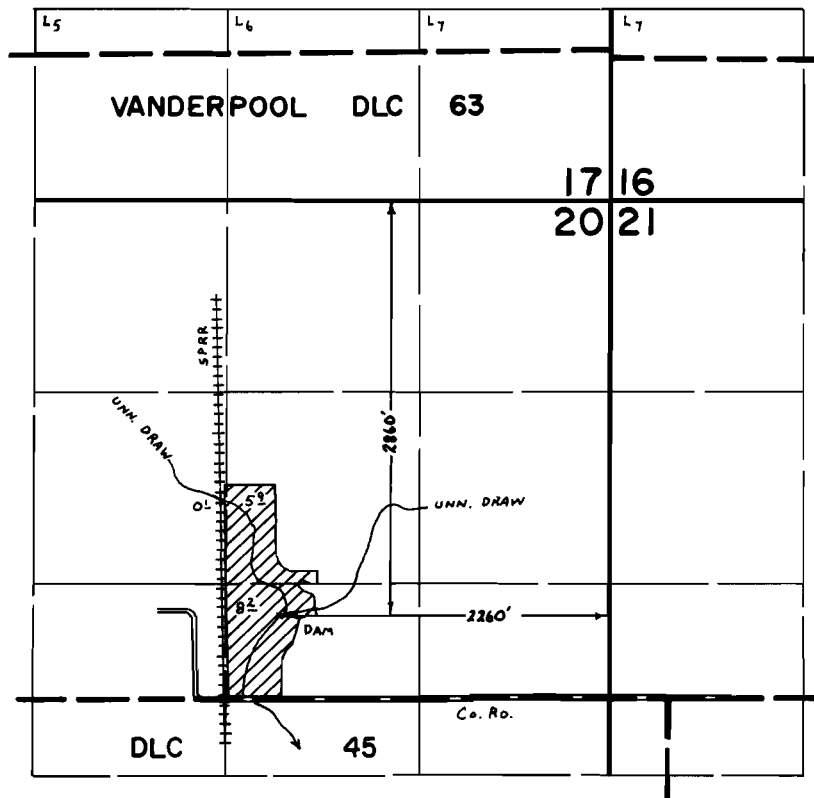

FINAL PROOF SURVEY UNDER

Application No. 50606 Permit No. 38243.....
IN NAME OF

RICHARD H. MILLER.....

Surveyed July 19, 1979, by C. L. HUGHES.....