


# T6S. R7W. WM.

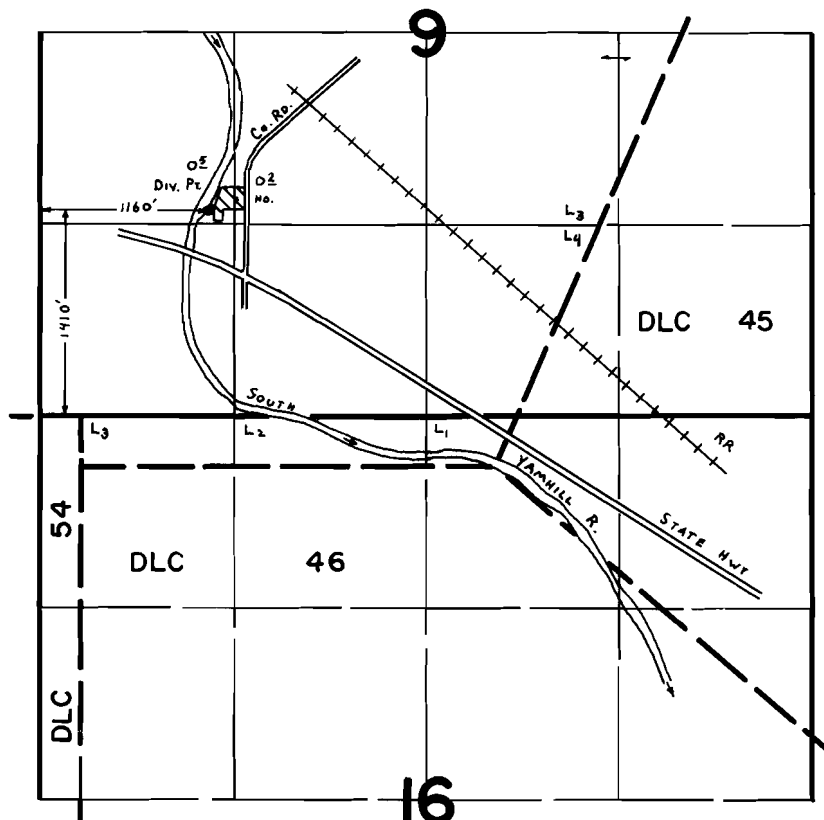

## FINAL PROOF SURVEY UNDER

Application No. 53127 Permit No. 38604.....  
IN NAME OF

.....ALICE HENTHORN.....

Surveyed June 5 1979, by C. L. HUGHES.....