


T6S. R7W. WM.

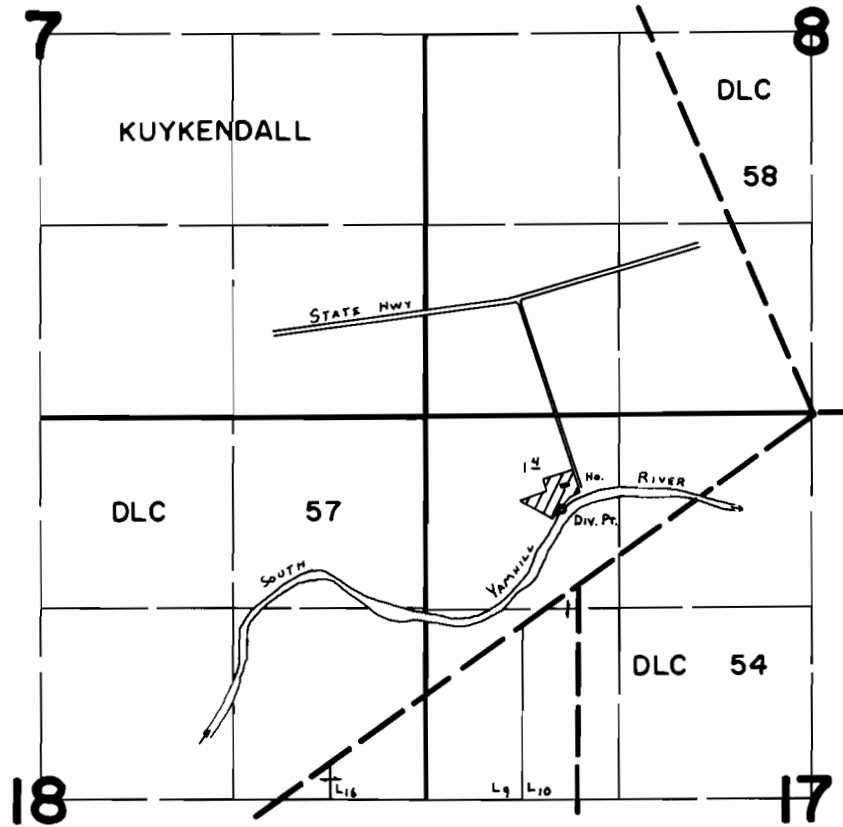

Div. Pt. Loc: 650' S. & 930' E. fr. N.W. Cor. SEC. 17.

FINAL PROOF SURVEY UNDER

Application No. 53007. Permit No. 40010.....
IN NAME OF

WILLIAM C. BOYCE

Surveyed June 6 1979, by C. L. HUGHES.....