


T. 1N. R. 38E. W.M.

Scale 1"=400'

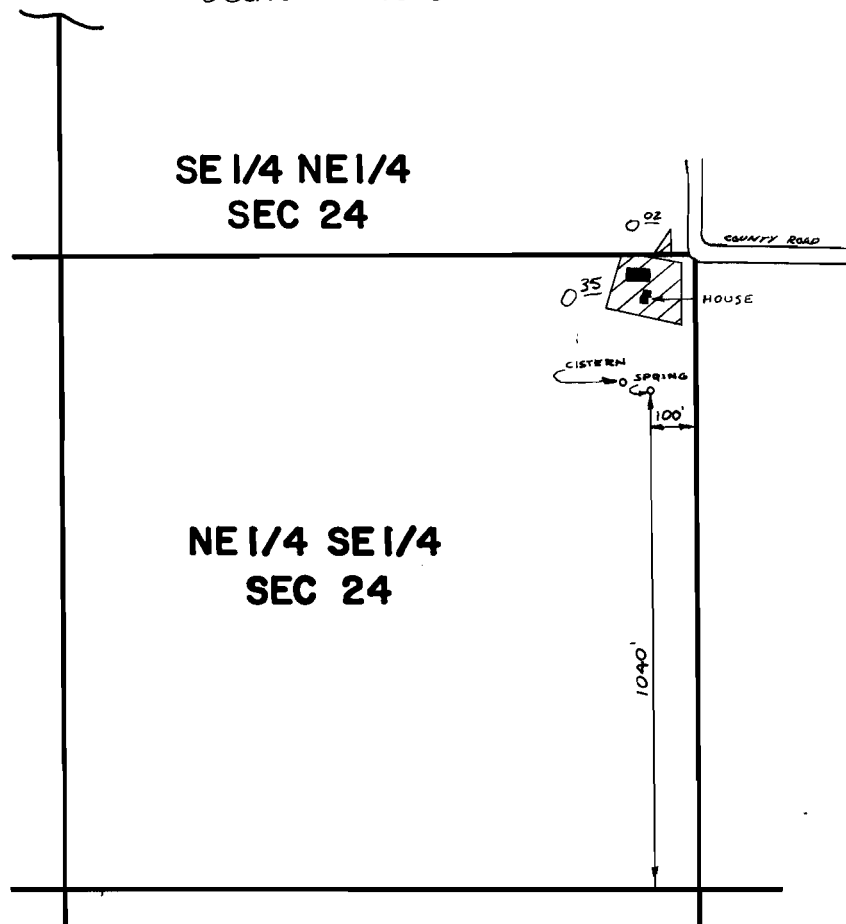

FINAL PROOF SURVEY
UNDER

Application No. **49741** Permit No. **37249**
IN NAME OF

DONALD A. HANSON

Surveyed **6-28** 1978, by **R. BARWIN**