


T. 1S., R. 38E., W.M.

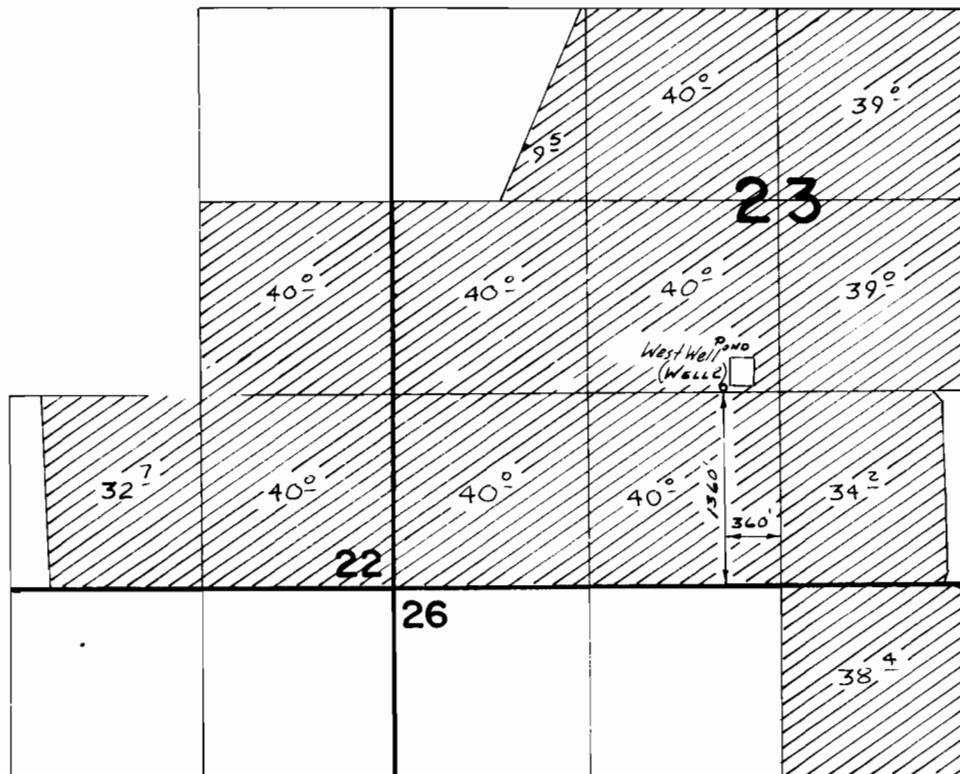

FINAL PROOF SURVEY
UNDER

Application No. **G:7385** Permit No. **G:6871**.....
IN NAME OF

.....**B. L. DAVIS RANCH, INC.**.....

Surveyed *June 21* 1978, by *V. L. Church*.....