


T2N R29 & 30E. W.M.

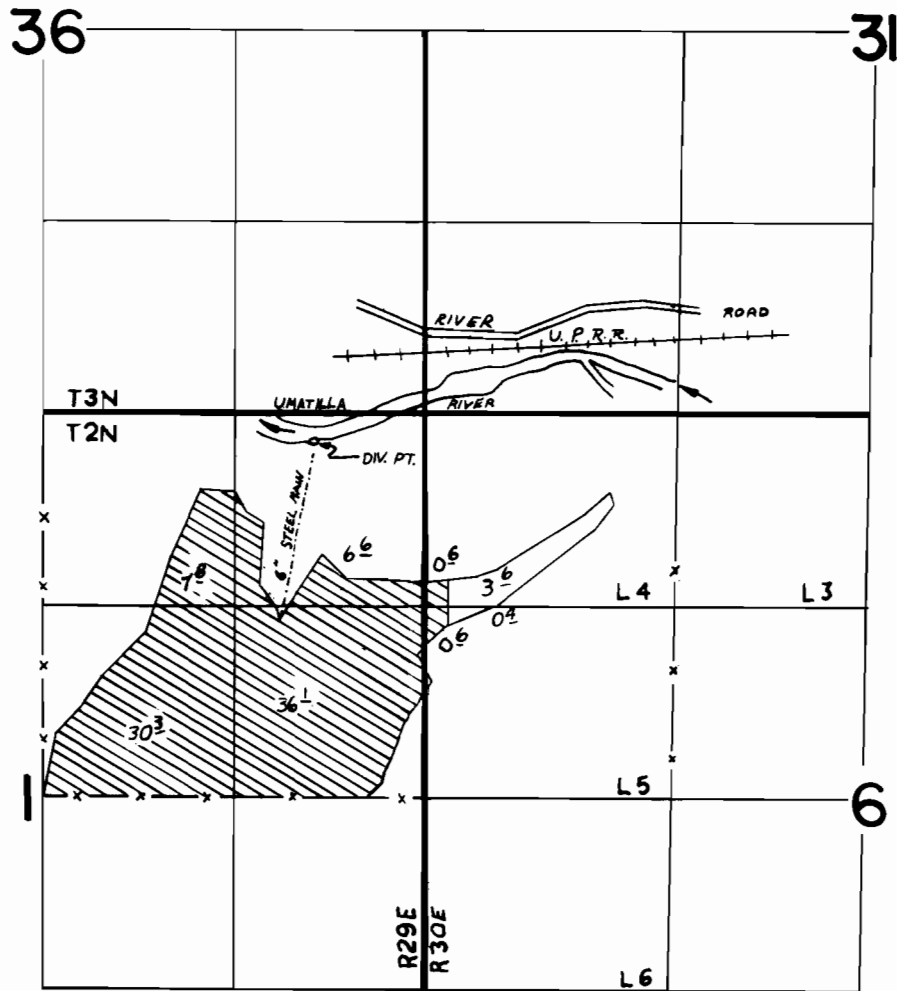

DIV. PT. LOCATED 200'S & 700'W FROM NE COR. OF
SEC 1

FINAL PROOF SURVEY UNDER

Application No. 51561 Permit No. 38899
IN NAME OF

..... HERBERT C. BORK

Surveyed FEB. 23. 1978. by R. BARWIN