


G-7097
52411

T.5N., R.28E., W.M.

SE1/4 SW1/4 SECTION 34

SCALE 1"= 400'

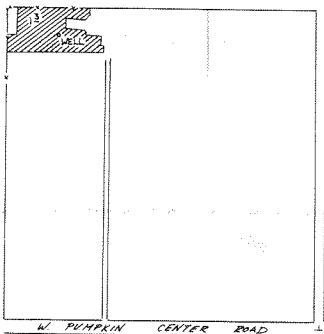

WELL LOC: 1200N. + 1100W. FROM SW COR. SEC. 34

FINAL PROOF SURVEY
UNDER

Application No. **G:7653** Permit No. **G:7097**
IN NAME OF

.....**CAROL HAMILTON**.....

Surveyed ..1..18..... 1984, by *R.H. Church*.....