


T. 4 S. R. 13 E. W.M.

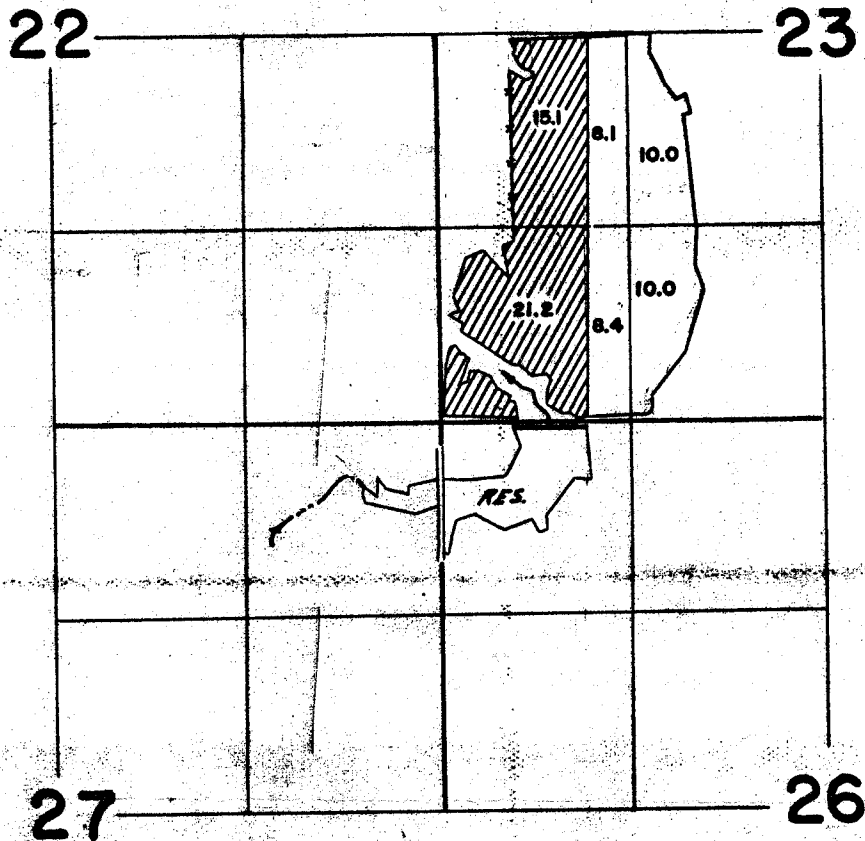

FINAL PROOF SURVEY
UNDER

38430

28619

Application No. R-38429 Permit No. R-3212..

IN NAME OF

.....**GLENN E. CHASTAIN**.....

Surveyed **JUNE 9 1965**, by **G. GARDNER**
MAY 20 **L. COLEBANK**