


T# 51466

# T.I.S. R.13E. W.M.

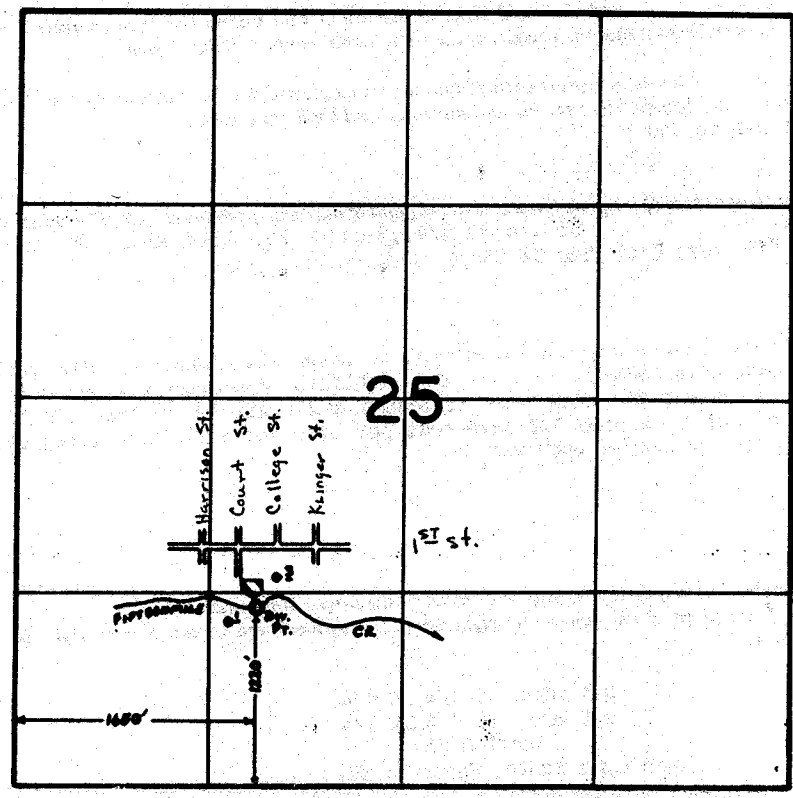

## FINAL PROOF SURVEY UNDER

Application No. 50278. Permit No. 37962....  
IN NAME OF

.....**VERNON LAUZON**.....

Surveyed JUN 26 1979, by G. L. HUGHES...