
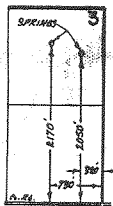


T. 4S. R. 12 E. W.M.

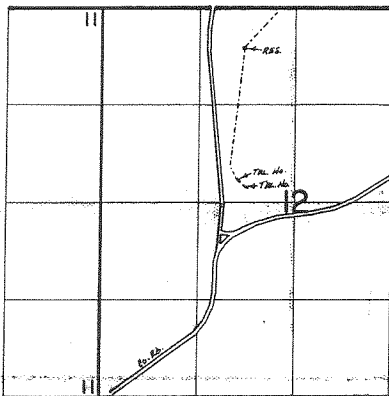

**FINAL PROOF SURVEY**  
UNDER

Application No. 57256. Permit No. 43089.  
IN NAME OF

Surveyed Nov. 9, 1983, by T. J. Paul