


T.4S. R.13E. W.M.

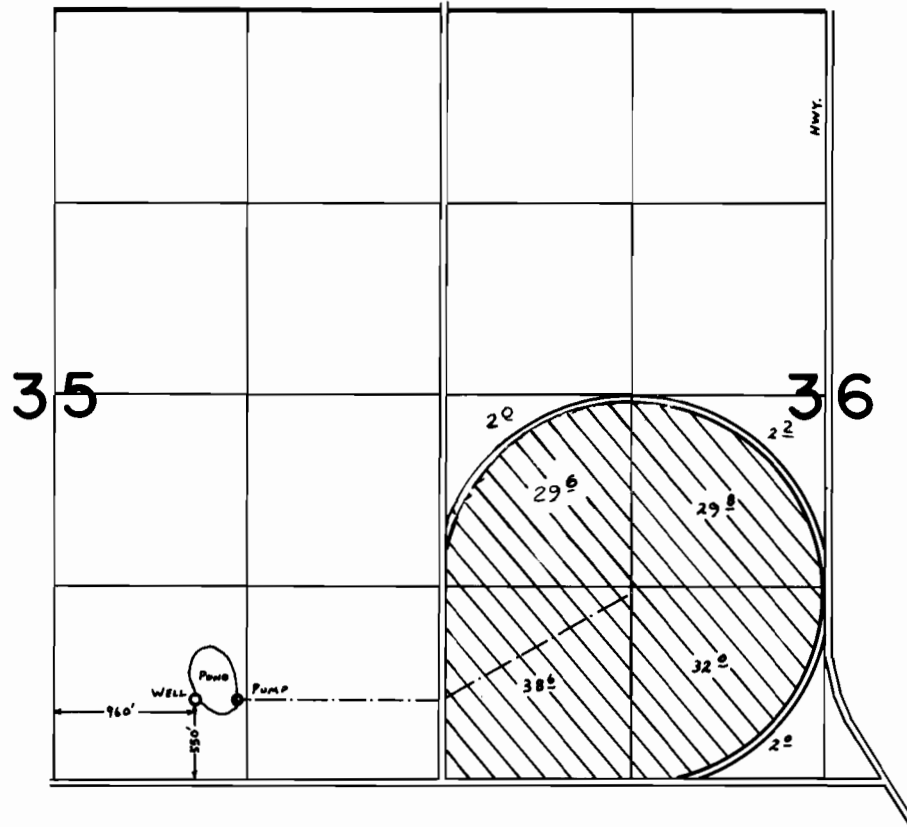

FINAL PROOF SURVEY
UNDER

Application No. ~~G-8242~~ Permit No. ~~G-7604~~
IN NAME OF

LELAND A. MAYHEW

Surveyed June 27, 1979, by C. L. HUGHES