


T. 2 N. R. 12 E. W. M.

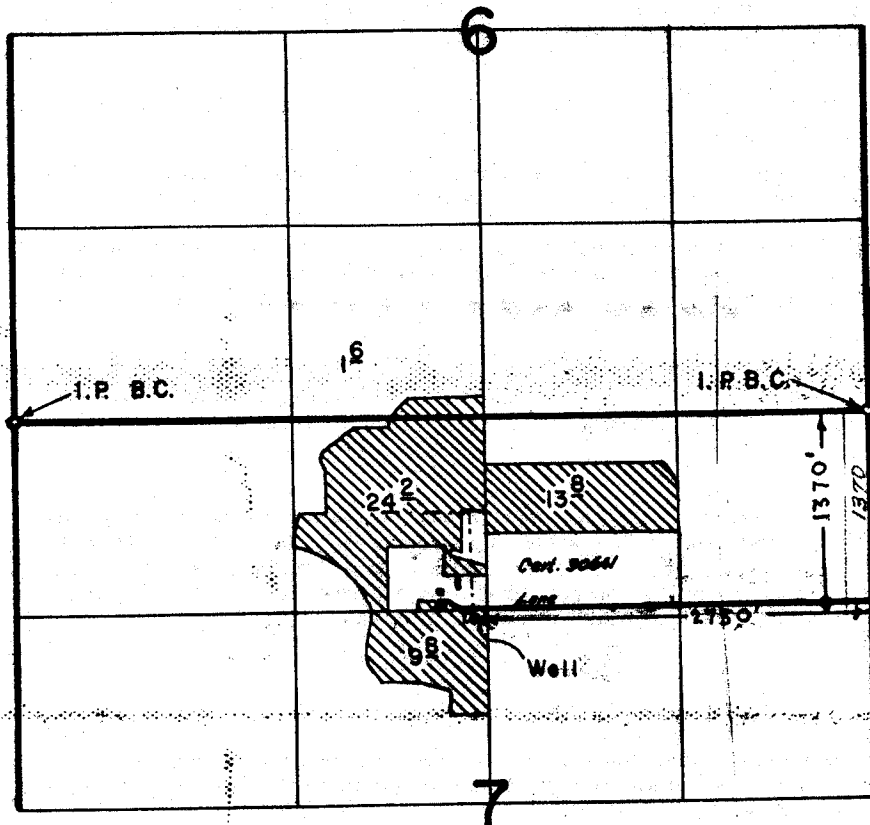

FINAL PROOF SURVEY
UNDER

Application No. G-8300. Permit No. G-7678.
IN NAME OF

VERNE L. ROOT

Surveyed March 11 1982, by T. Paul