


P-42331

52419

T.11S. R20E. W.M.

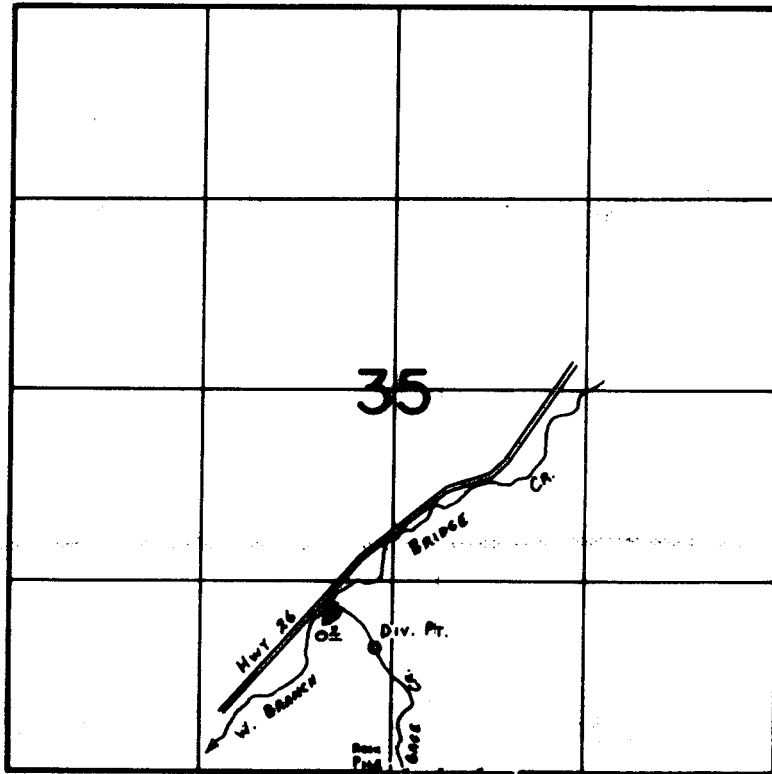

Div. Pt. Loc: 860' N. & 120' W. fr. S. 1/4, Cor. Sec 35.

FINAL PROOF SURVEY
UNDER

Application No. **56344**. Permit No. **42331**.....
IN NAME OF

ELLIS G. PAINTER.....

Surveyed **JULY 23, 1979**, by **C. L. HUGHES**.....