

RECEIVED
JUN 5 1969
STATE ENGINEER
SALEM, OREGON

SURVEY OF:


WATER INTAKE SITES TIED TO THE
WEST 1/4 CORNER OF SEC. 3, T.4N., R.7W.,
W.M., CLATSOP COUNTY, OREGON

FOR:

LOYD MORGAN

BY:

BURTON BROS. ENGRS.
314 S.E. 102nd AVE.
PORTLAND, ORE.
PH. 255-3035 or 281-0471
BEND, ORE., OFFICE
PH. 382-6347

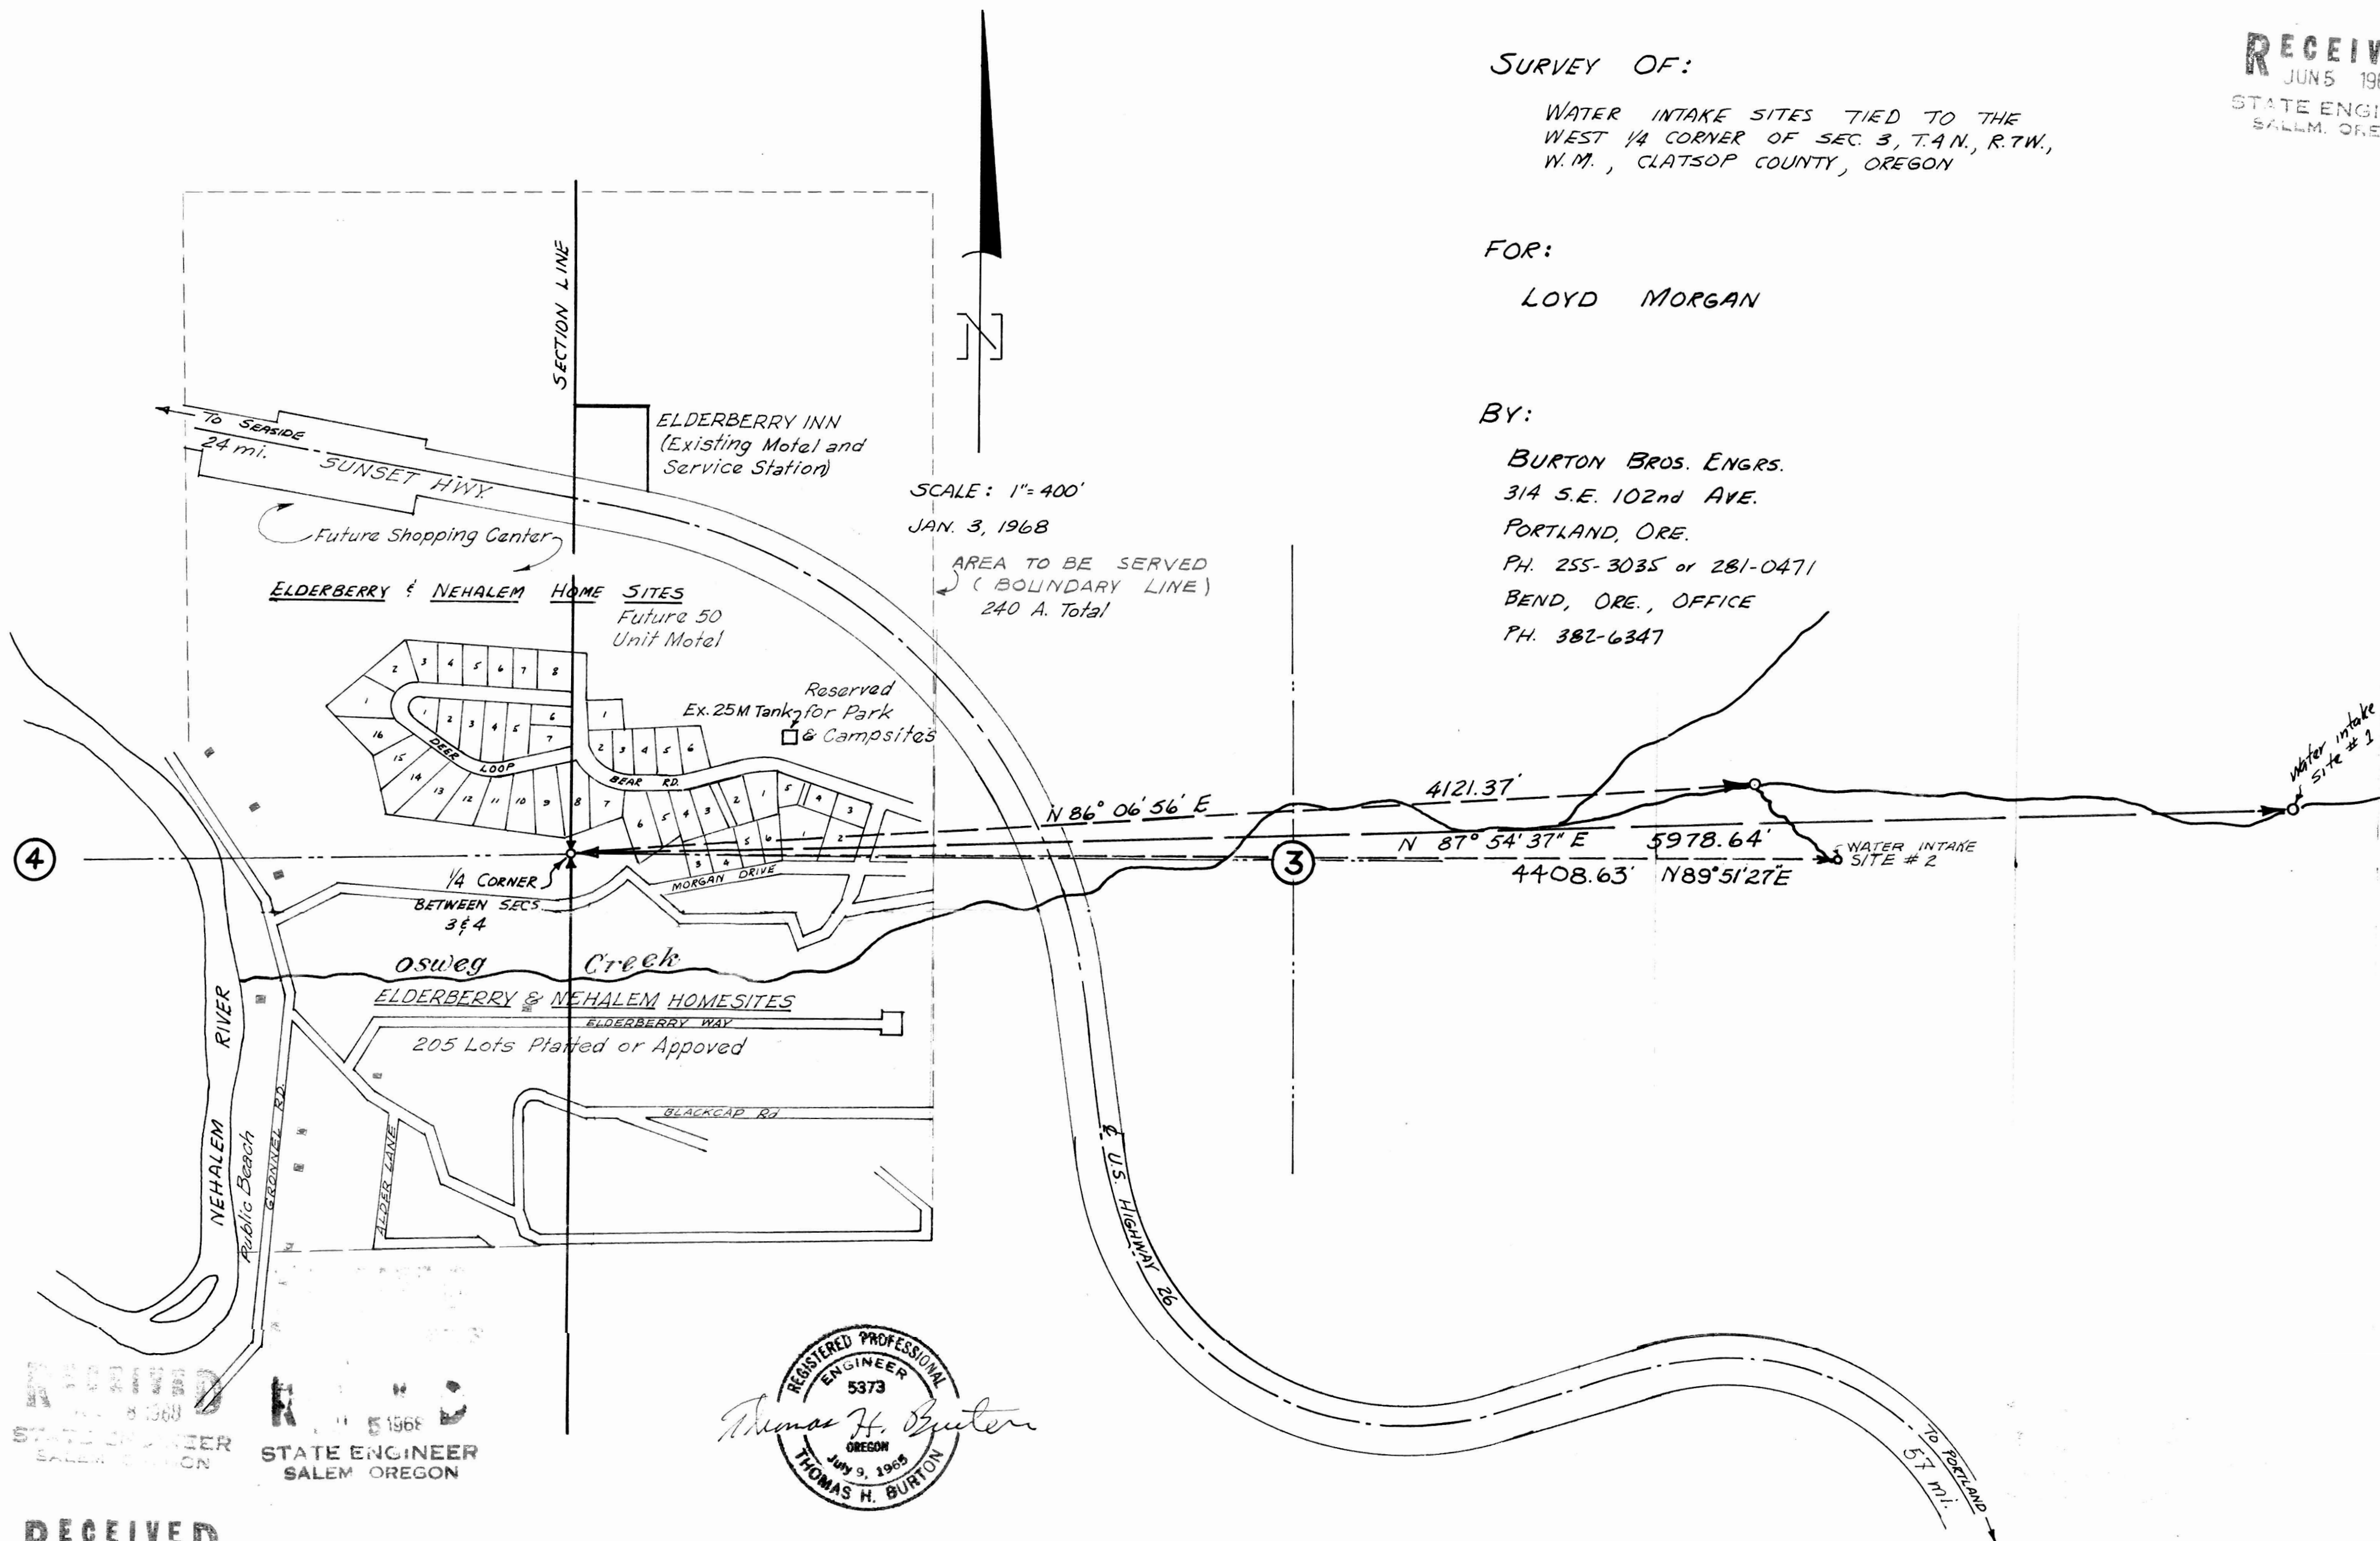

RECEIVED
JUN 5 1969
STATE ENGINEER
SALEM, OREGON

RECEIVED
JUN 5 1969
STATE ENGINEER
SALEM, OREGON

REGISTERED PROFESSIONAL
ENGINEER
5373
THOMAS H. BURTON
JULY 9, 1968
OREGON

RECEIVED
JUN 5 1969
STATE ENGINEER
SALEM, OREGON

44369
3/10/66