

T.17S.R.21E.W.M.

FINAL PROOF SURVEY

R-24576                      R-1422  
 R-24577                      R-1423  
 Application No. 24572 Permit No. 21721



IN NAME OF

F. Miles Mayfield

Surveyed Aug. 5, 1957, by C.O. Butch

21721 #182

2400  
 5250  
 ab 018

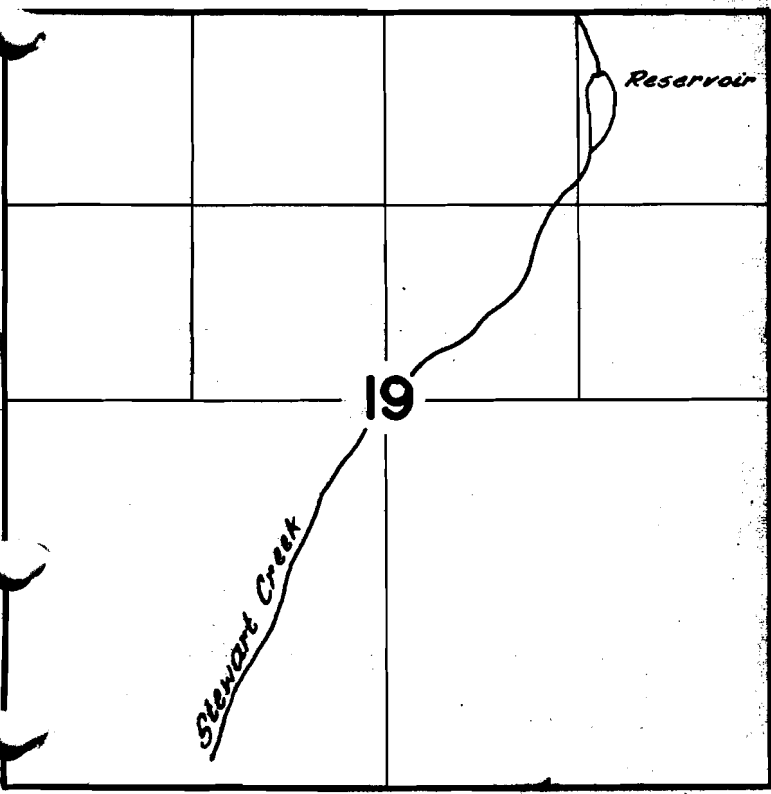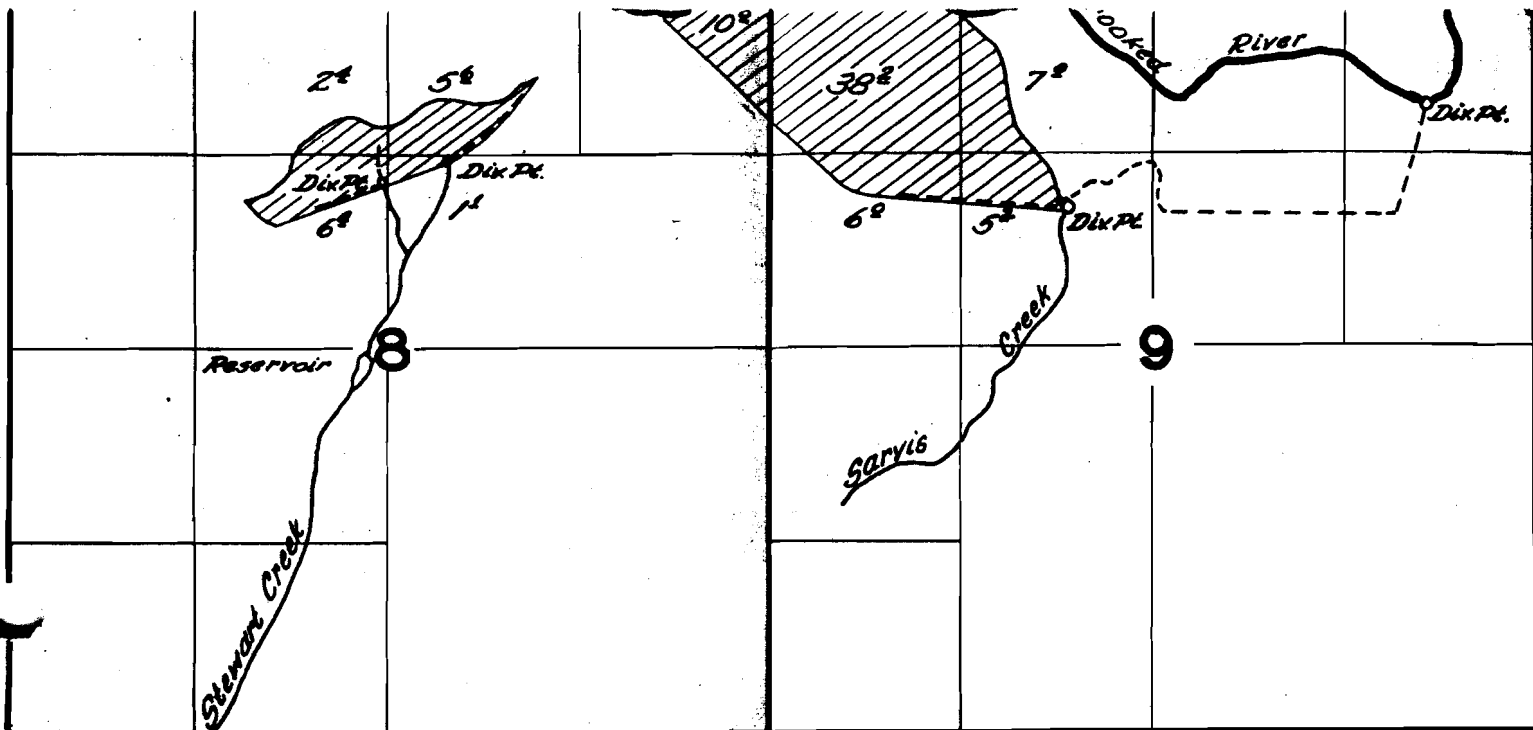

T.17S.R.21E.W.M.

FINAL PROOF SURVEY

R-24576 R-1422  
 R-24577 R-1423  
 Application No. 24572 Permit No. 21721

IN NAME OF

E. Miles Mayfield

Surveyed Aug. 5, 1957, by C.O. Burtch

C-24090

DCV-13N-25

pt. of Dix in 2359  
 30 P 193

#1002  
 21721