


T. 26 S., R. 3 W., W.M.

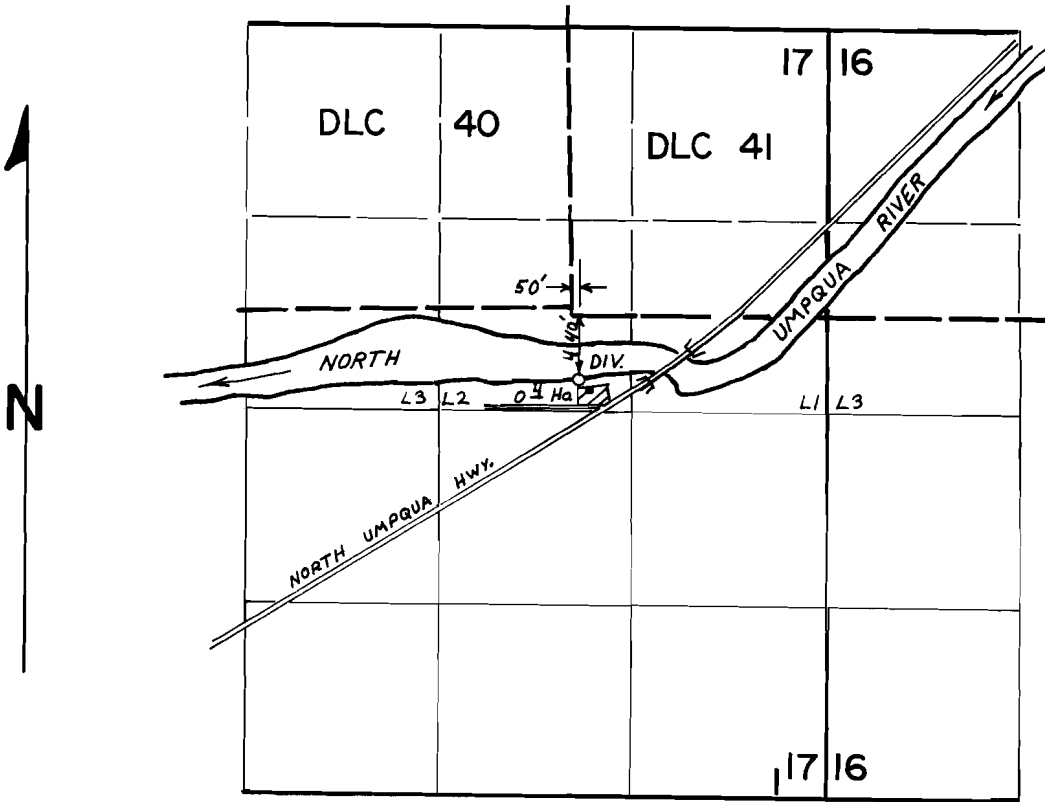

SCALE: 4" = 1 mile

**FINAL PROOF SURVEY**  
UNDER

Application No. 54864 Permit No. 41154.....  
IN NAME OF

LEO F. WYNDEARO

Surveyed AUG. 30 19. 84 by *L.E. Cashion*