


T.26S., R.3W., W.M.

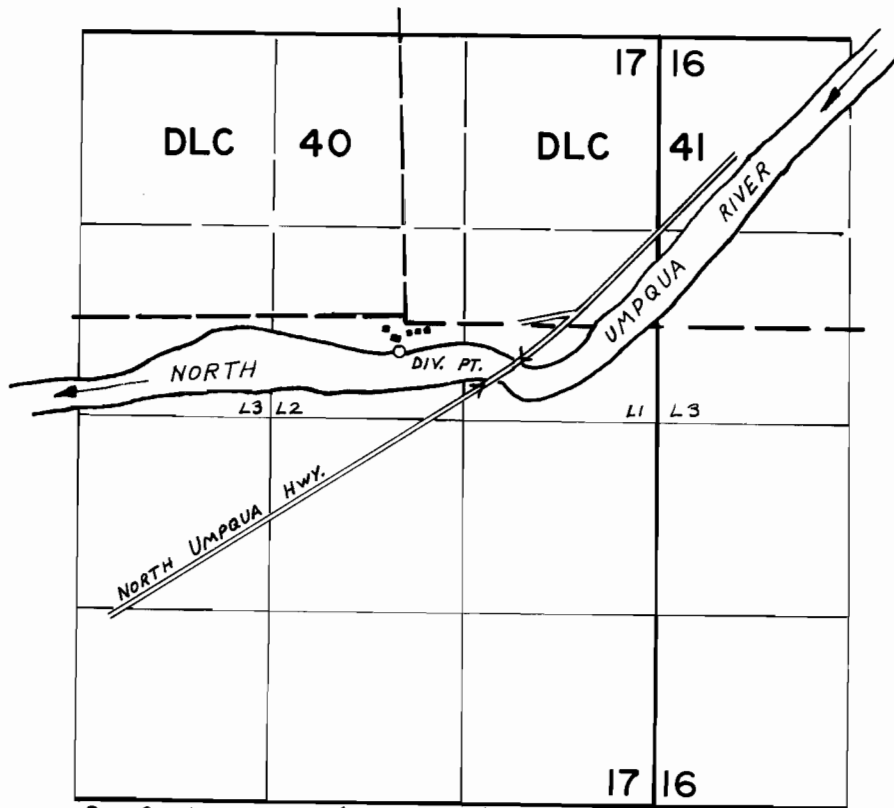

DIV PT LOCATED 200'S. AND 50'W. FROM S.W. CORNER OF
DLC 41.

SCALE: 4" = 1 mile

FINAL PROOF SURVEY
UNDER

Application No. 55064... Permit No. 41293.....
IN NAME OF

GUENTHER P & MARGARITE HUBRICH

Surveyed OCT. 17, 1984, by *J.E. Cashion*...