


T. 32 S. R. 5 W. M.

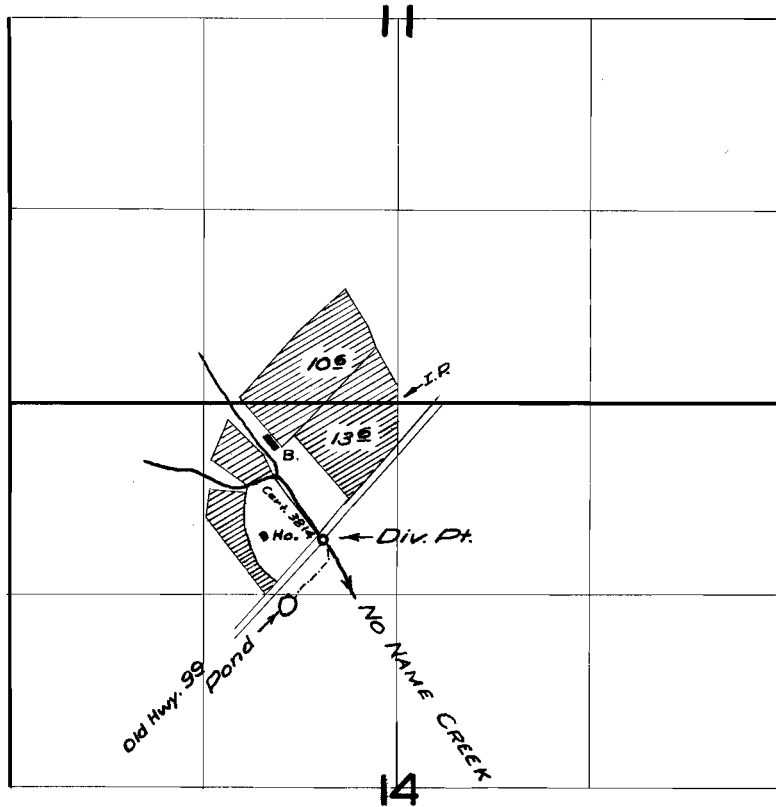

FINAL PROOF SURVEY
UNDER

Application No. 29460 Permit No. 23185
IN NAME OF

Mrs. H.U. France

Surveyed 6 Sept. 1958, by M. B. Bish