


T.30S.R.5W.W.M.

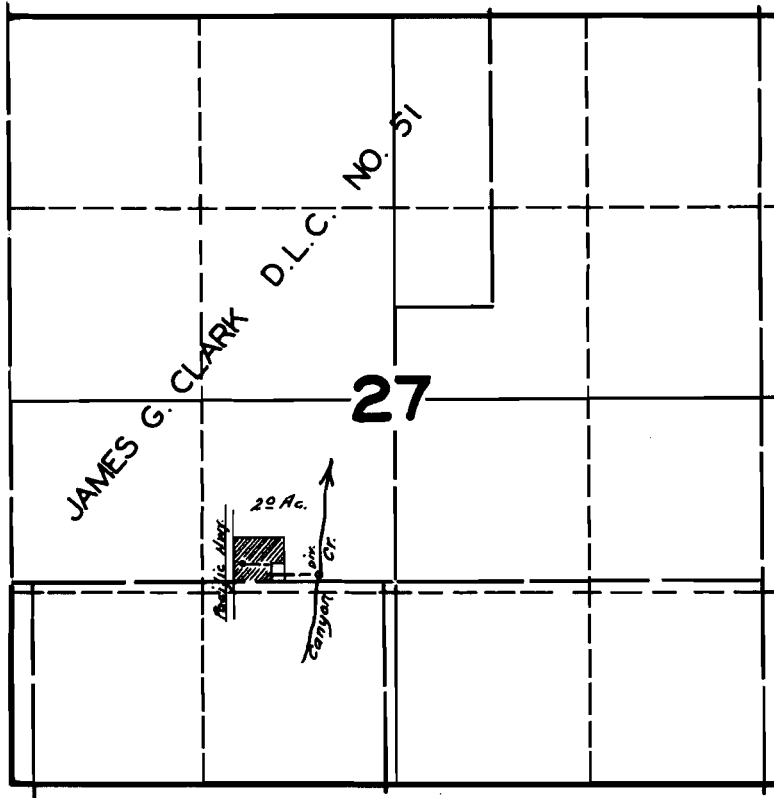

FINAL PROOF SURVEY UNDER

Application No. 20182 Permit No. 15683

IN NAME OF

GEO. J. MC. CLANE

Surveyed JULY 13 1945 by [Signature]