


T.16S., R.2W., W.M.

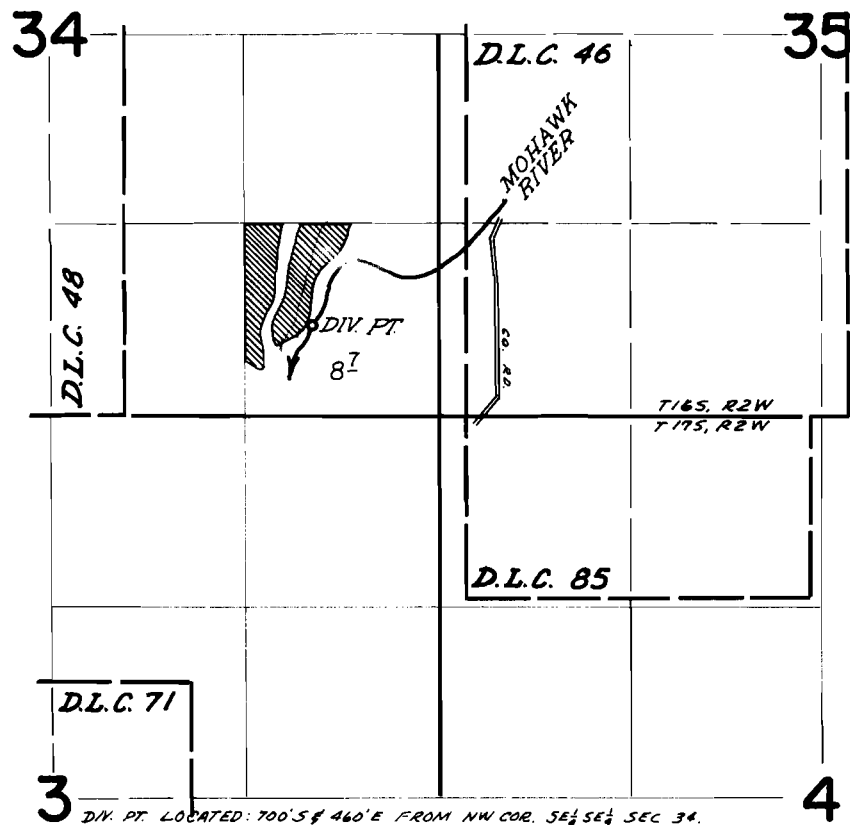

FINAL PROOF SURVEY  
UNDER

Application No. 45943 Permit No. 34321  
IN NAME OF

NED ARTER

Surveyed APRIL 30 1973, by D. NORBY