


T.14S.R.9W.W.M.

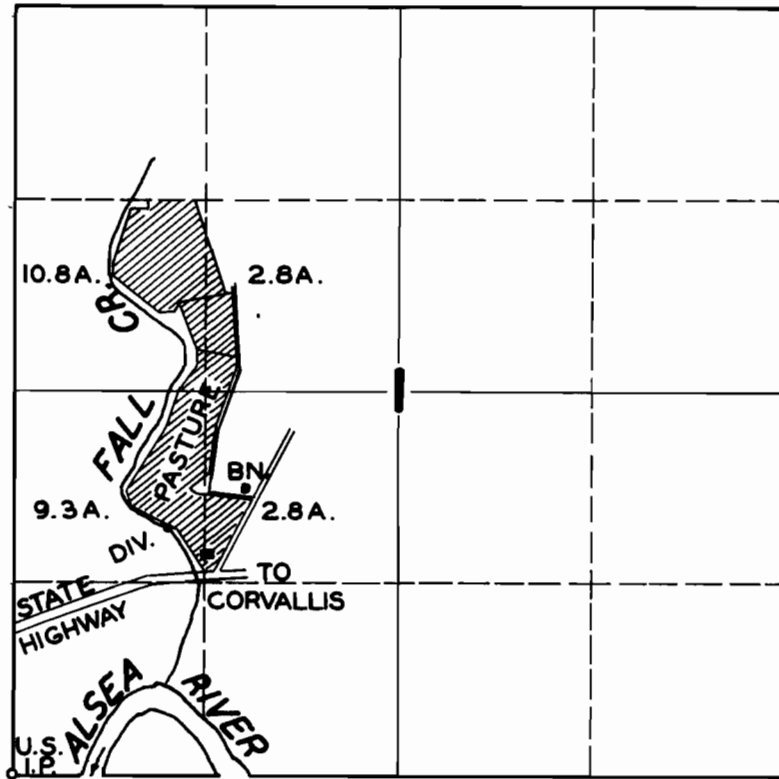

FINAL PROOF SURVEY UNDER

Application No. 19325 Permit No. 14905
IN NAME OF

RUSSELL K. WOODRUFF

Surveyed AUG. 4 1948, by JAS. E. BUNNELL