


7

G-1991

31290
35279
41943
46239
52572

T.6N.R.35&36E.W.M.

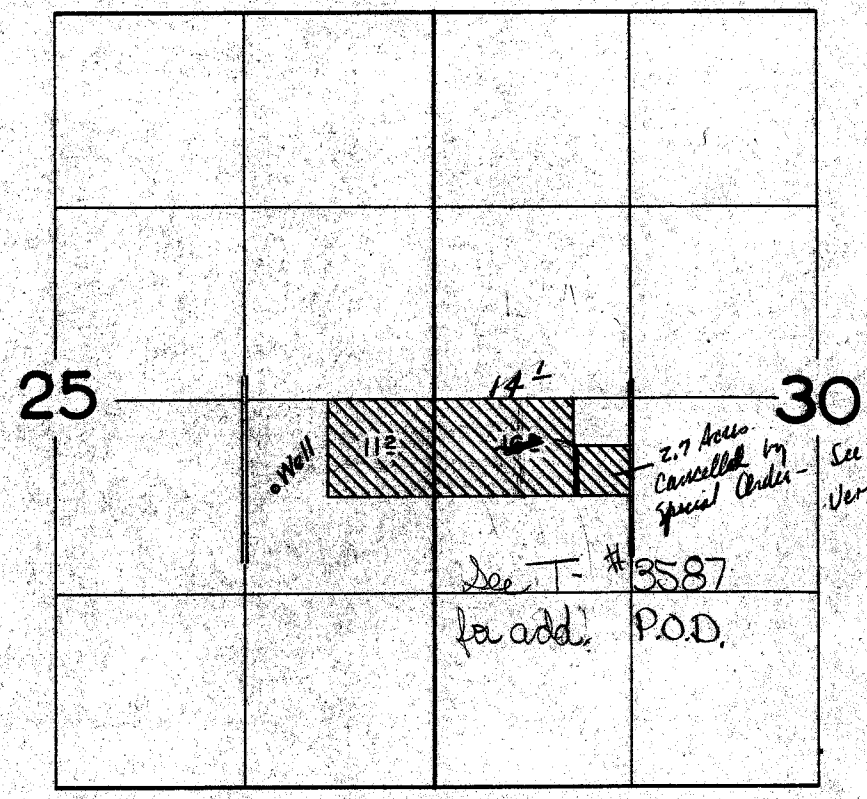

FINAL PROOF SURVEY UNDER

Application No. G-2153 Permit No. G-1991
IN NAME OF

VERNON E. BRUMBACH

Surveyed May 3 1962, by L.H. Jackson