


T. 4N., R. 29E., W.M.

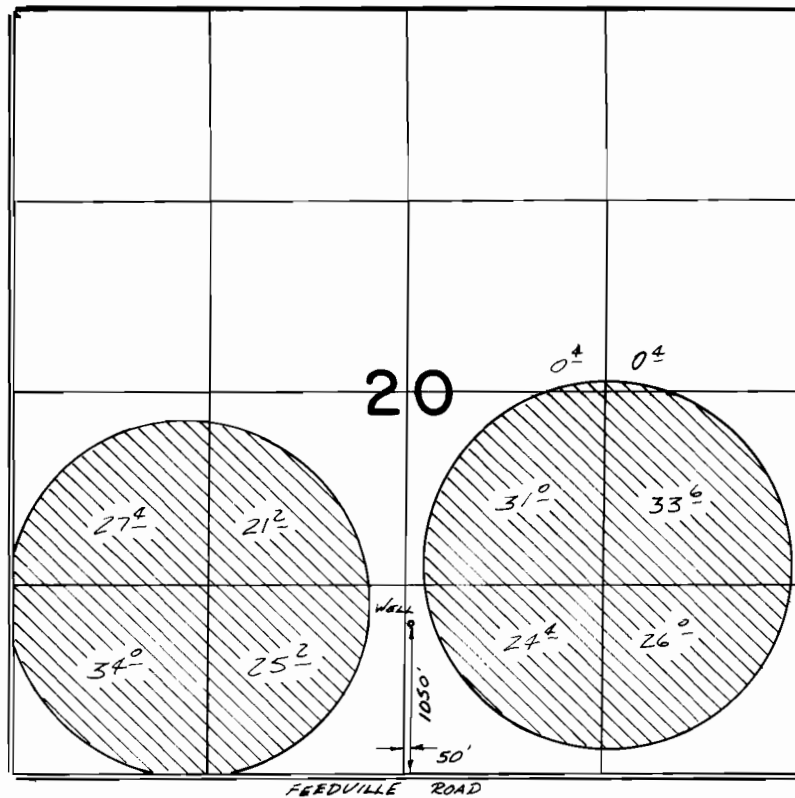

**FINAL PROOF SURVEY**  
UNDER

Application No. **G:7844** Permit No. **G:7182**....  
IN NAME OF

**..VERNON & IVAN.....COOK.....**

Surveyed *Aug...7.....* 19*82*., by *V.L. Church*.....