


T.5&6N. R.35E. W.M.

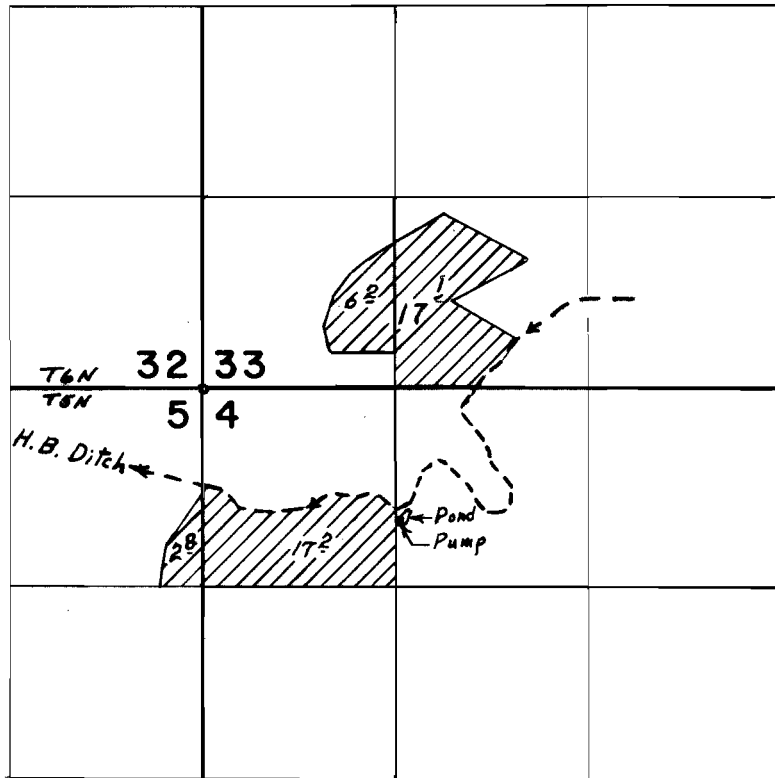

FINAL PROOF SURVEY
UNDER

Application No. Transfer H-131
..... Permit No.
IN NAME OF

C. H. HARRIS

Surveyed May 13, 1971, by Greg Baca