


T. 7S., R. 46E., W.M.

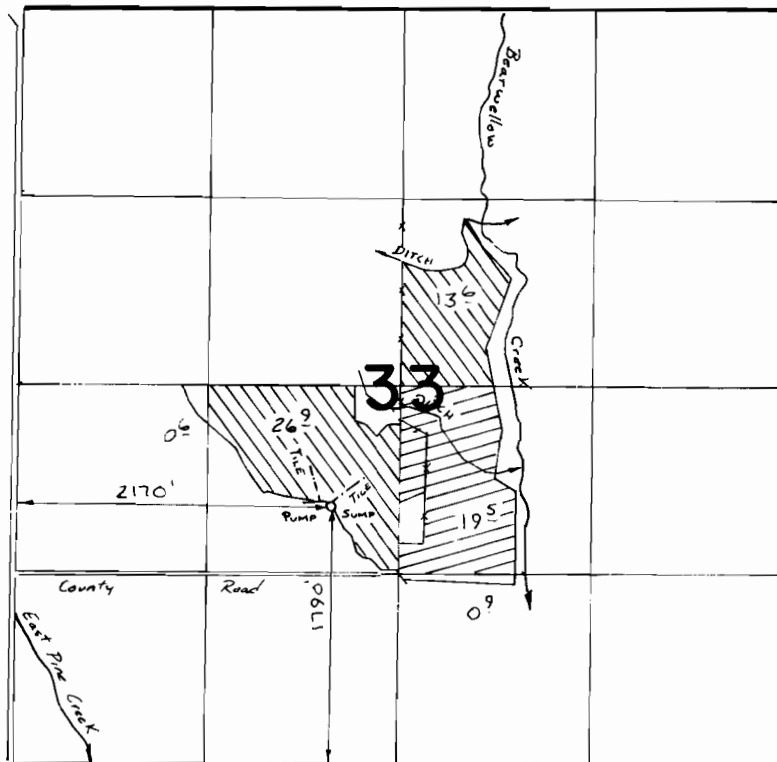

Primary



Supplemental

FINAL PROOF SURVEY

UNDER



SCALE: 1" = 1320'

Application No. G:8282 Permit No. G:7752...
IN NAME OF

.....LORVAL JOHNSON.....

Surveyed 11-13..... 1978., by R.F. Bacon.....