


T. 10S. R. 40E. W.M.

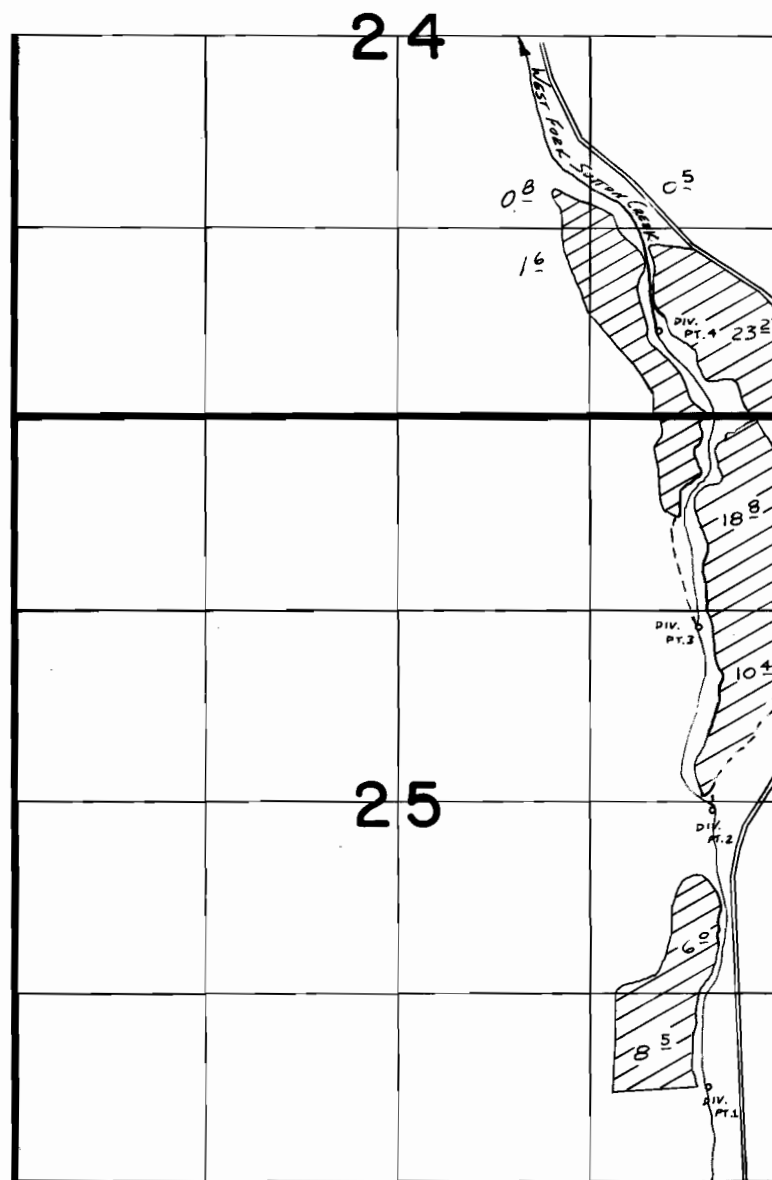

DIVERSION POINT 1 LOCATED 670' N. & 500' W. FROM SE COR SEC 25
DIVERSION POINT 2 LOCATED 50' S. & 480' W. FROM E. 1/4 COR SEC 25
DIVERSION POINT 3 LOCATED 1200' N. & 600' W. FROM E. 1/4 COR SEC 25
DIVERSION POINT 4 LOCATED 590' N. & 850' W. FROM SE COR SEC 24

FINAL PROOF SURVEY UNDER

APPL. 55577 PER. 42126

IN NAME OF

FREEMAN ANGUS RANCH, INC.

SURVEYED 11-2 1978, BY R. BARWIN