


T. 8S. R. 46E. W.M.

**RECEIVED**

OCT 1 1984

WATER RESOURCES DEPT  
SALEM, OREGON

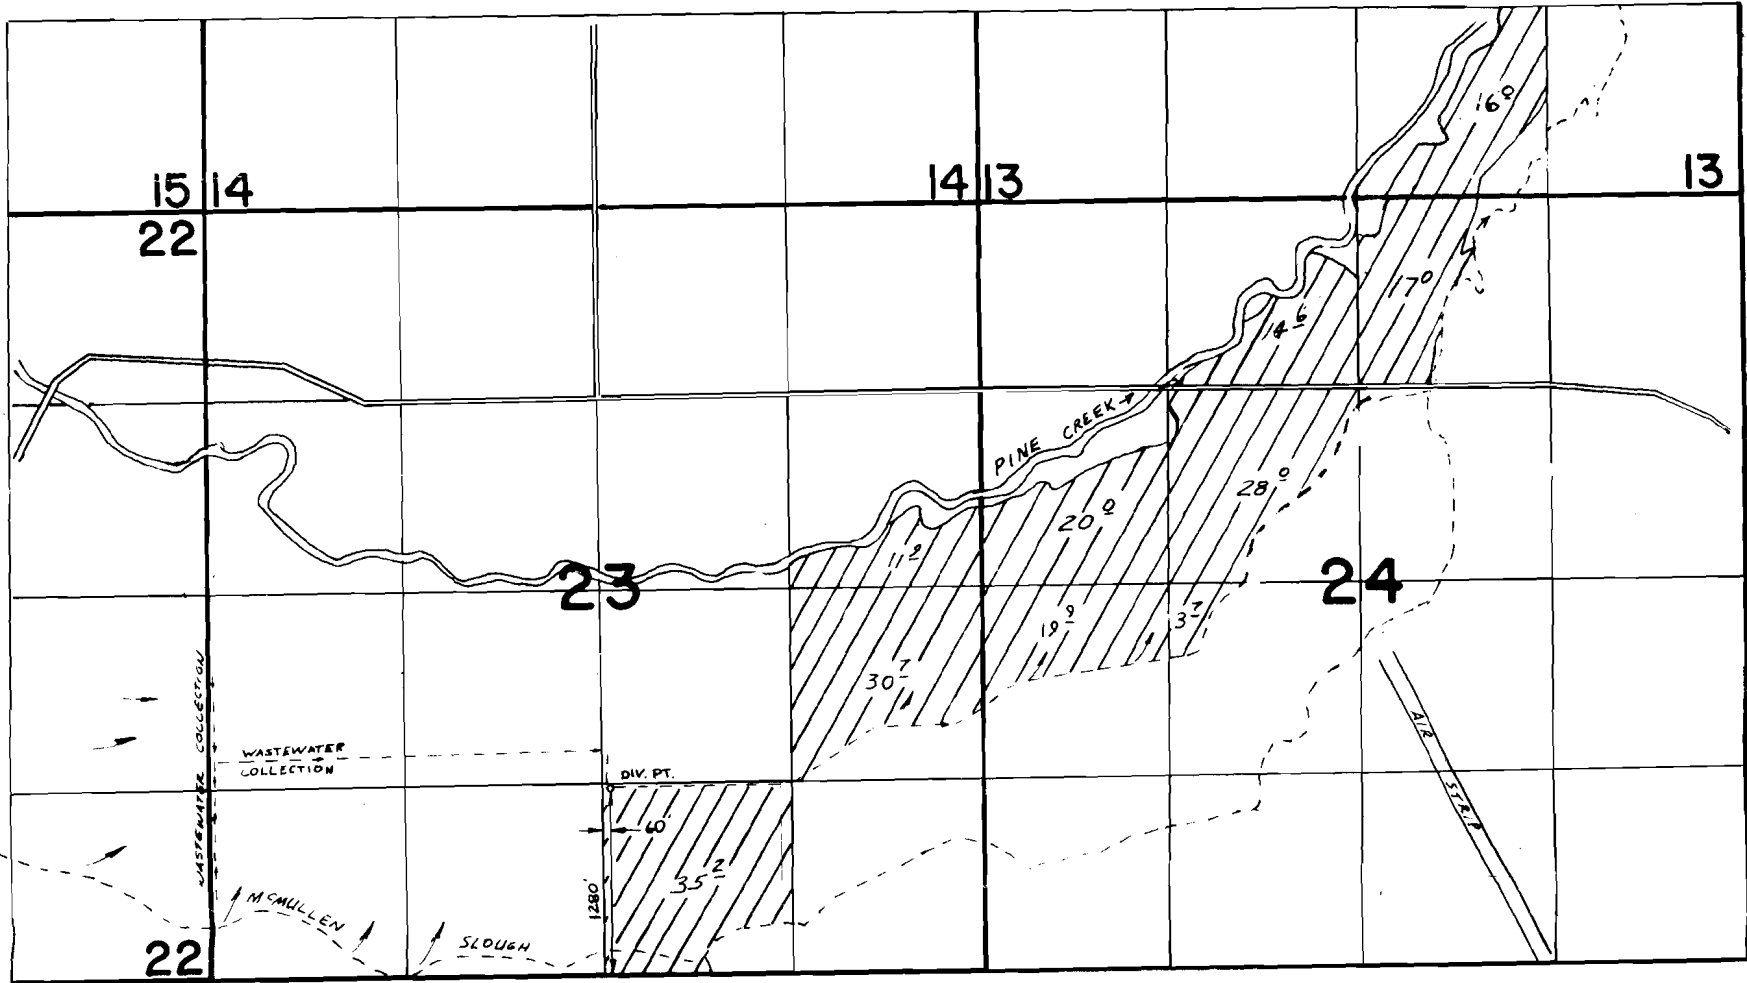

**FINAL PROOF SURVEY**

UNDER

APPL 57046 PER. 42721

IN NAME OF

**JERRY B. TORRANCE**

*SURVEYED NOV 14 15 1978 by R BARWIN*