


T. 7S., R. 45E., W. M.

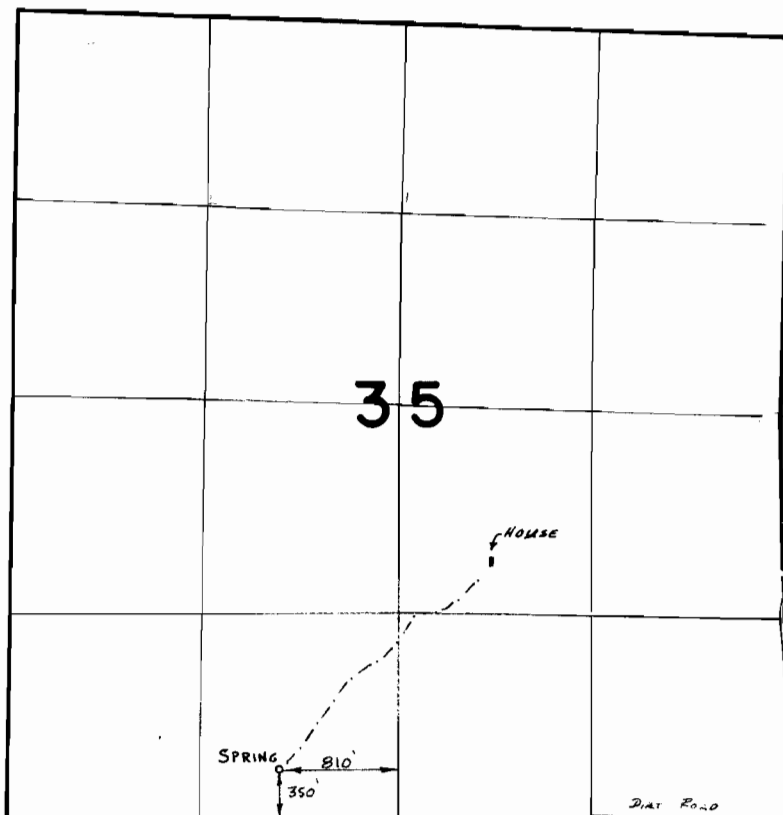

FINAL PROOF SURVEY
UNDER



SCALE: 1" = 1320'

Application No. **55609** Permit No. **41666**.....
IN NAME OF

.....**GEORGE D. BRYAN**.....

Surveyed *11-14*..... 19*78*., by *R. BARWIK*.....