


T13 & 14S. R5W. WM.

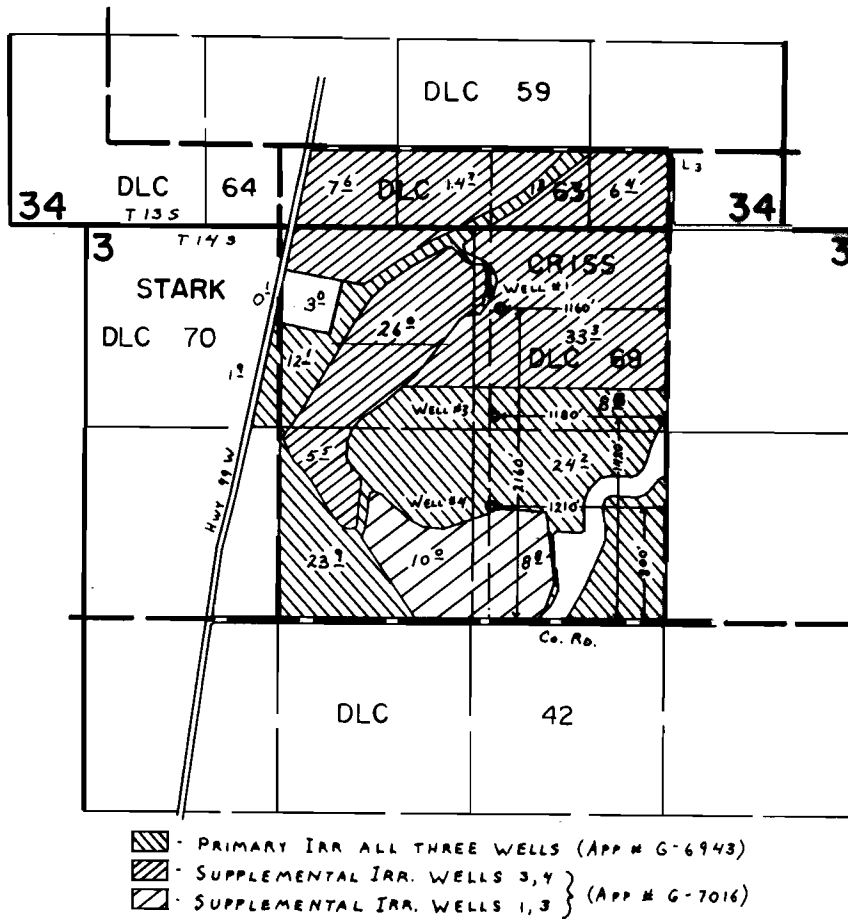

FINAL PROOF SURVEY UNDER

G-6943 G-6458
 Application No. G-7016 Permit No. G-6515.....
 IN NAME OF

.....**EARL FRANKLIN**.....

Surveyed Sept. 6 1979, by C. L. HUGHES.....