


T13 & 14S. R5W. WM.

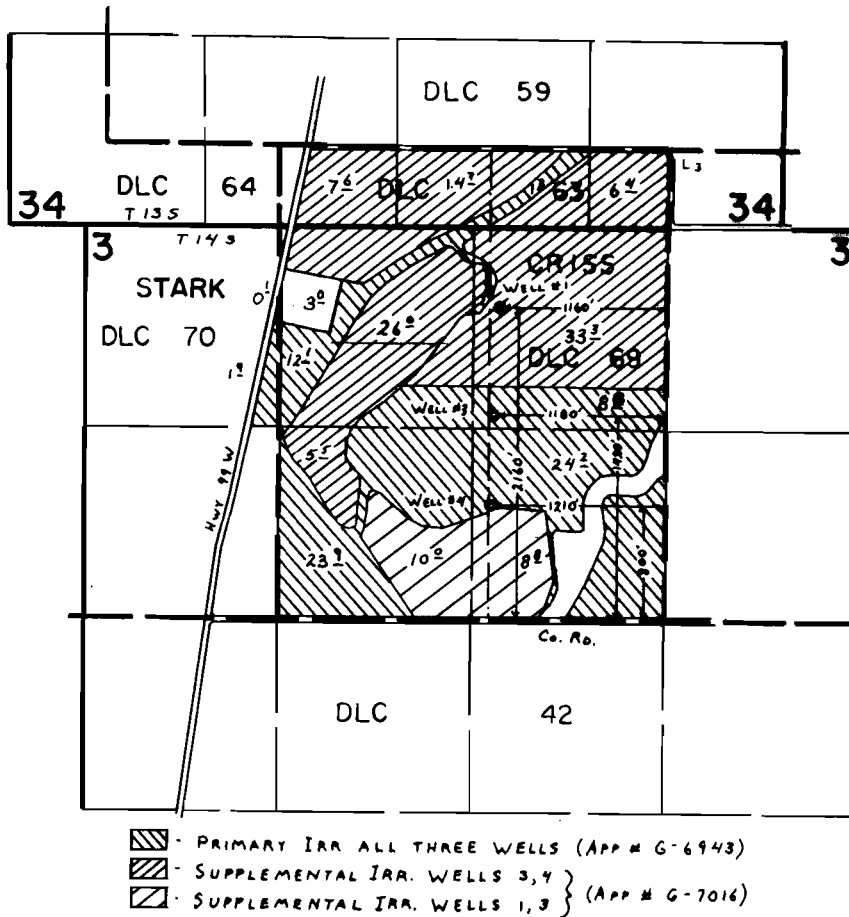

FINAL PROOF SURVEY UNDER

G-6943 G-6458
 Application No. G-7016 Permit No. G-6515.....
 IN NAME OF

EARL FRANKLIN.....

Surveyed Sept 6 1979, by C.L. HUGHES.....