


T13S. R5W. WM.

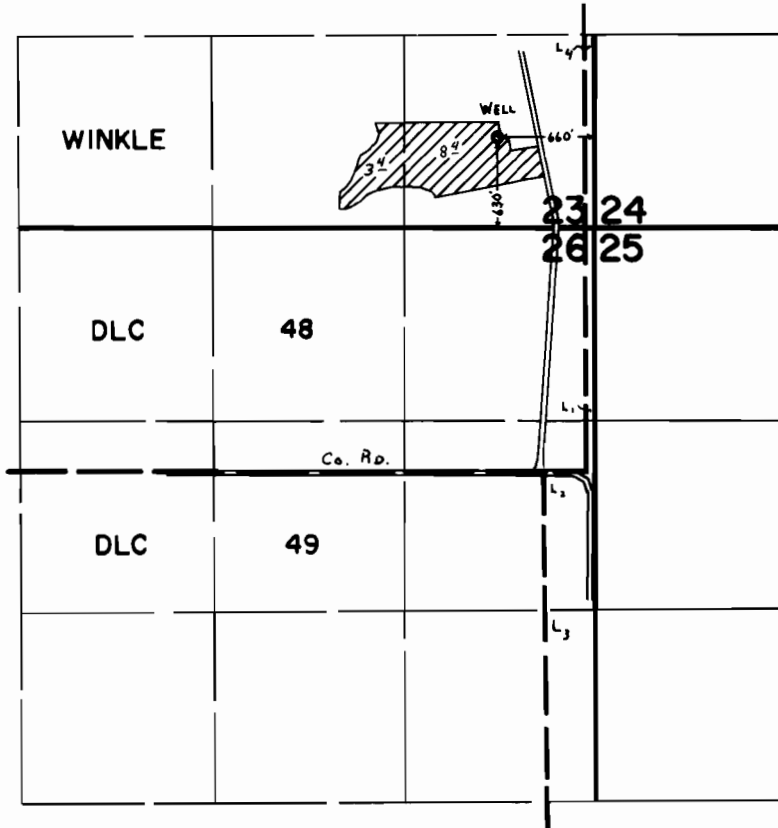

FINAL PROOF SURVEY UNDER

Application No. G-6400 Permit No. G-5989....
IN NAME OF

.....GALE ALLEN MILLER.....

Surveyed Aug. 17, 1979, by C. L. HUGHES....